


T. 38S., R. 4W., W.M.

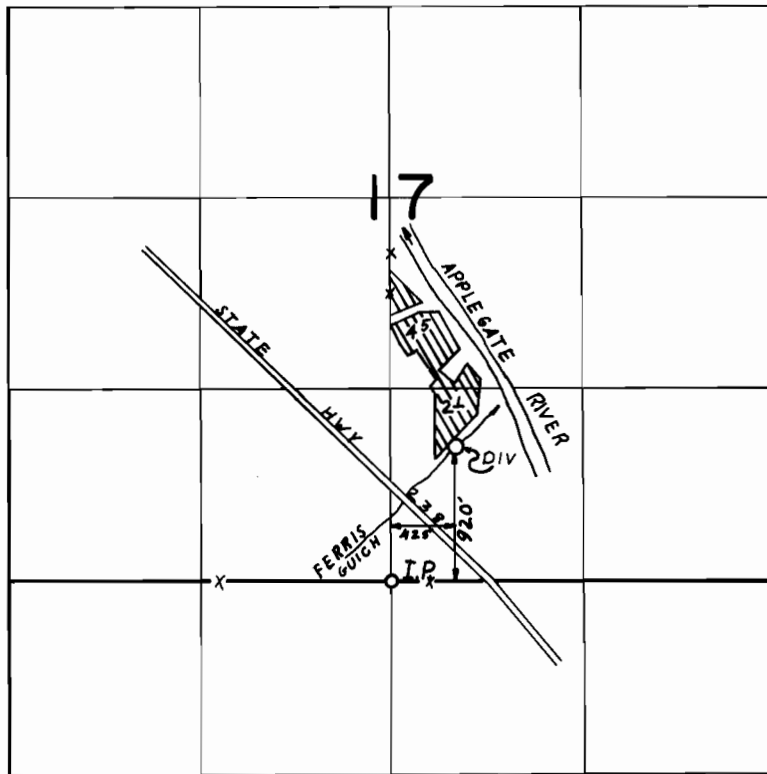

FINAL PROOF SURVEY
UNDER

Application No. ...49209... Permit No. ...36888...
IN NAME OF

.....**ELDON C. SNYDER**.....

Surveyed APR 29 1976, by C.R. KING.....