


T.38S.,R.4W.,W.M.

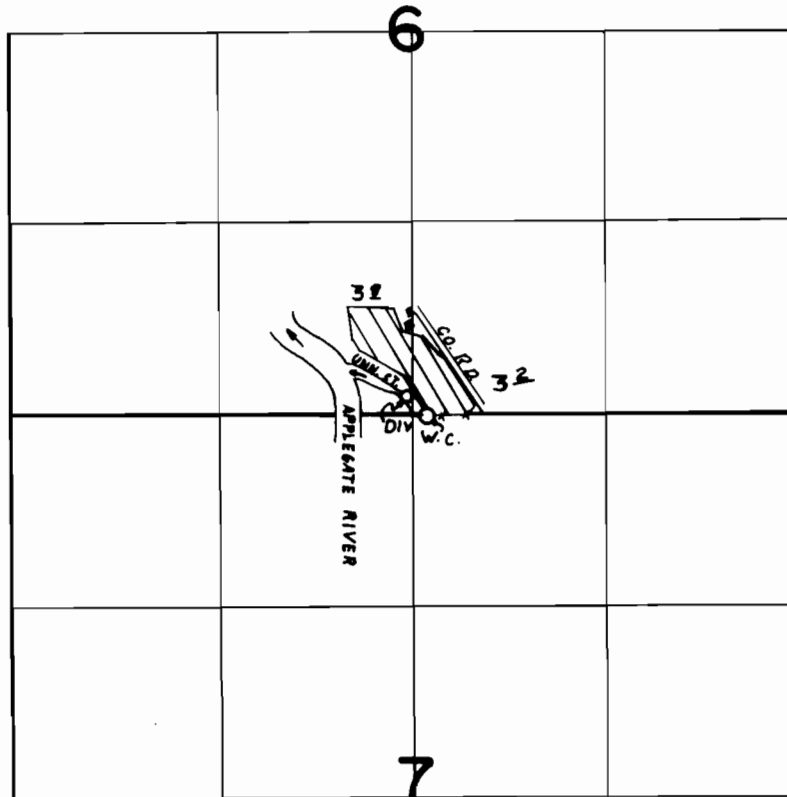

DIV: 125' N & 35' W FROM 5/4 COR SEC. 6

FINAL PROOF SURVEY
UNDER

Application No. 50591 Permit No. 38188
IN NAME OF

RALPH D. TIPTON

Surveyed APR 28 1976, by C.R. KING