


20285

36763
36764

T. 38 S. R. 38 4 E. W. M.

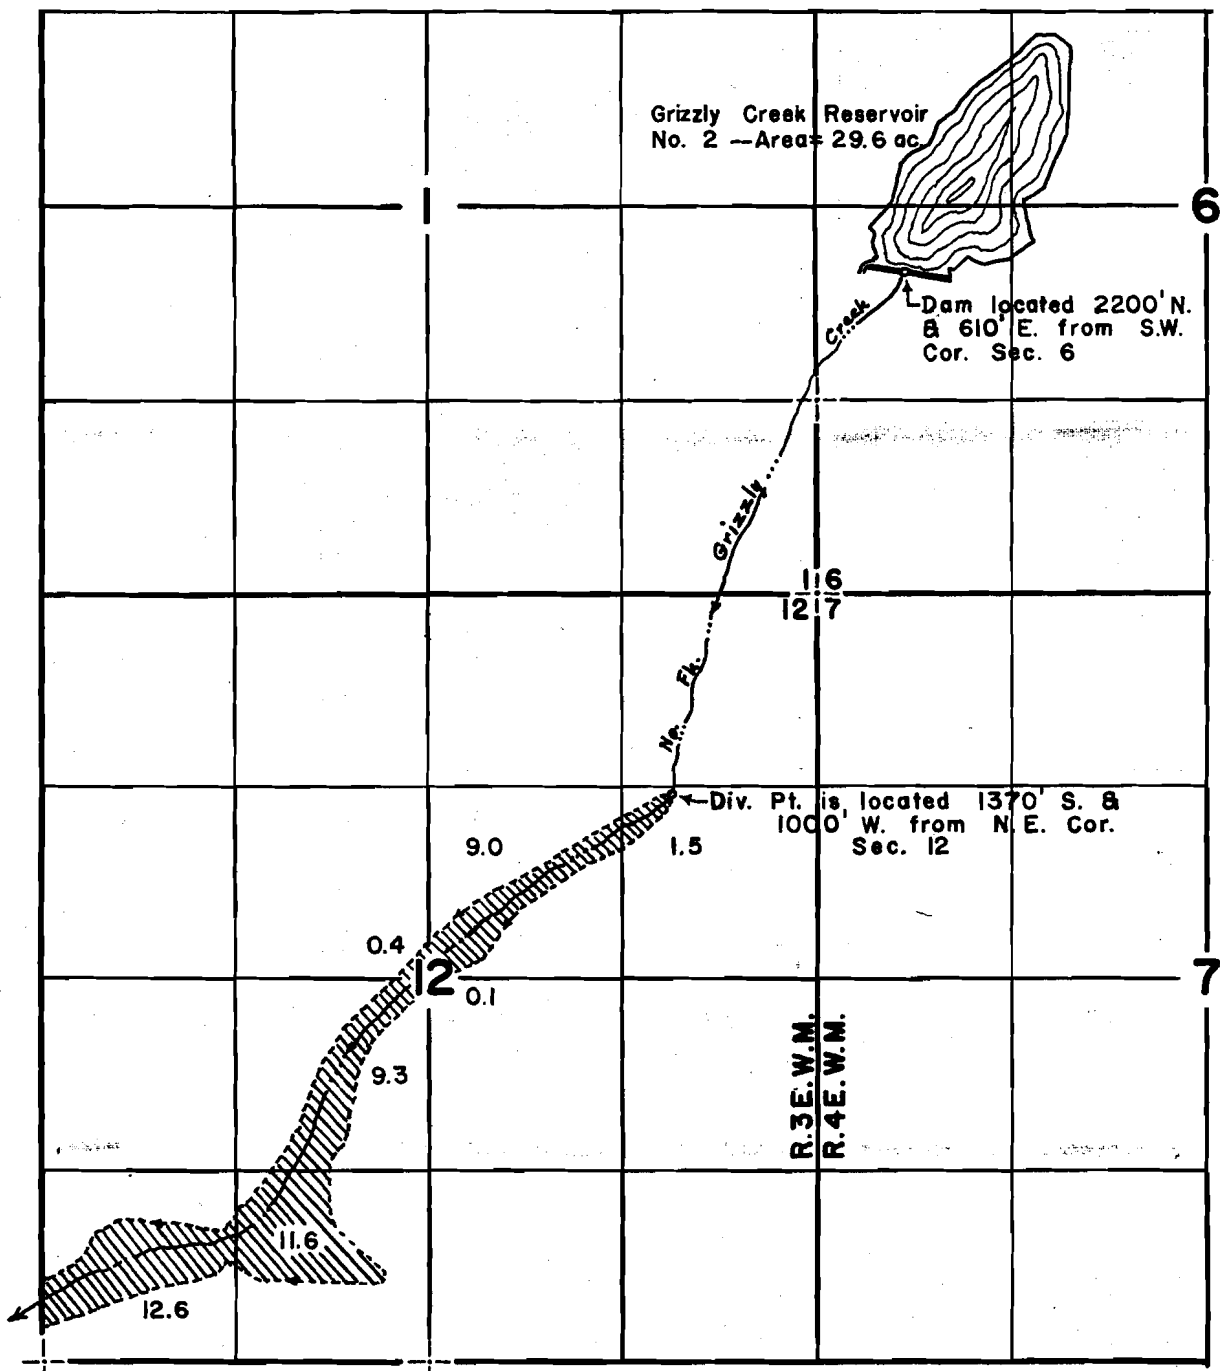

FINAL PROOF SURVEY
UNDER

R-25817 R-1163
Application No. 25818 Permit No. 20285
IN NAME OF

Henry A. Owens

Surveyed May 21, 1963, by C. Baker