


T. 36 S. R. 5 W. W. M.

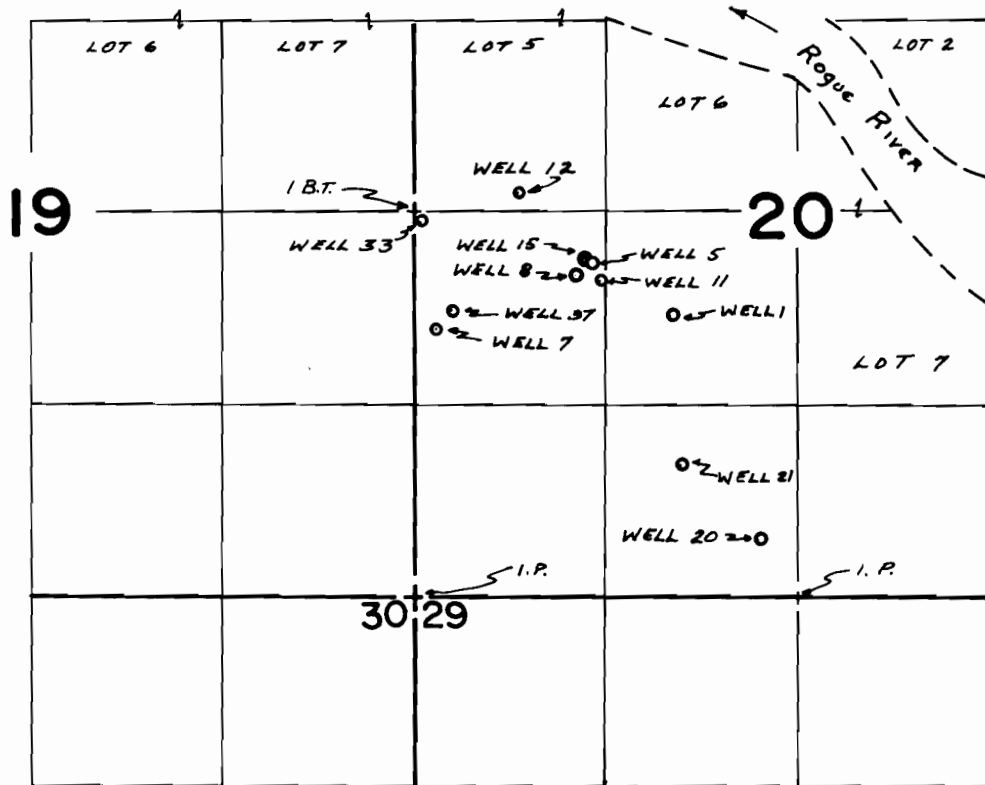

- WELL LOCATIONS;
- # 1 - 1940' N 850' W
 - # 20 - 400' N 260' W
 - # 21 - 910' N 780' W
 - # 7 - 780' S 160' E
 - # 12 - 140' N 710' E
 - # 38 - 50' S 50' E
 - # 37 - 660' S 270' E
 - # 5 - 2300' N 1220' E
 - # 8 - 2210' N 1110' E
 - # 11 - 2180' N 1270' E
 - # 15 - 2320' N 1170' E
- } ALL FROM S 1/4 COR. SEC. 20
- } ALL FROM W 1/4 COR. SEC. 20
- } ALL FROM NW COR. SEC. 29

FINAL PROOF SURVEY UNDER

Application No. G-2677 Permit No. G-2586
IN NAME OF

FRUITDALE WATER UTILITIES

Surveyed April 29, 1970, by L.E. Gould