


T.39S.,R.5W.,W.M.

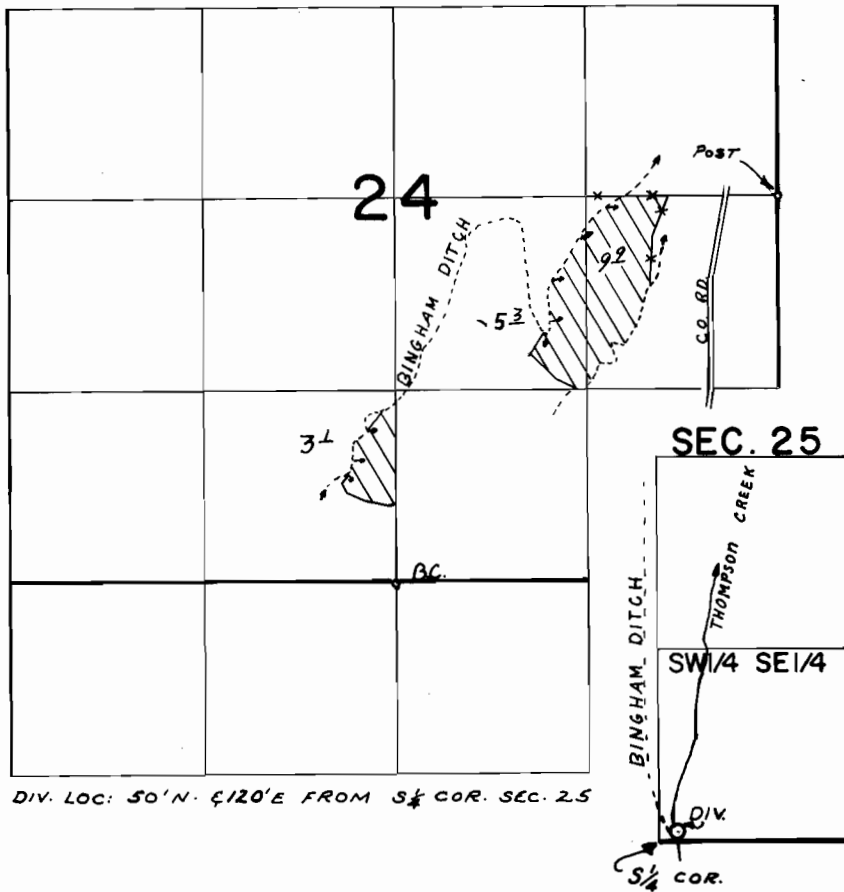

DIV. LOC: 50' N. 4120' E FROM S 1/4 COR. SEC. 25

FINAL PROOF SURVEY
UNDER

Application No. 44434 Permit No. 33188
IN NAME OF

FLORENCE BROSS

Surveyed MAY 3, 1976, by C.R. KING