


T.6S.,R.10W.,W.M.

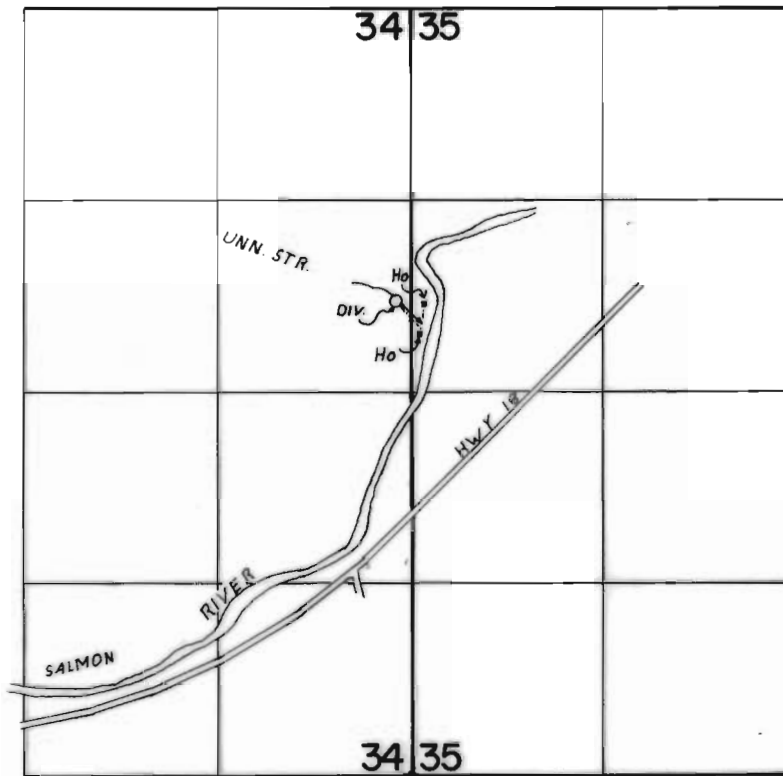

DIV: 610' N & 100' W FROM THE E. 1/4 COR OF SEC. 34

FINAL PROOF SURVEY
UNDER

Application No. 50919 Permit No. 38444
IN NAME OF

ROY H. & ETHEL N. GIBBS

Surveyed JUNE 28, 1976, by C.R. KING