


T.8S.,R.11W.,W.M.

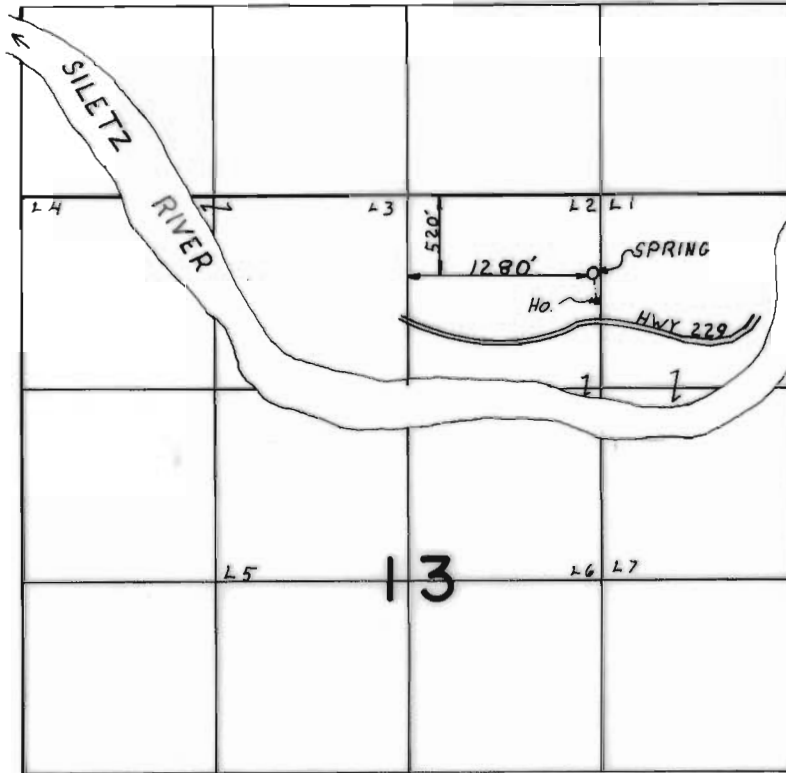

**FINAL PROOF SURVEY**  
UNDER

Application No. 50949 Permit No. 38462  
IN NAME OF

PAUL & GERALDINE WOODRUM

Surveyed JUNE 30 1976, by C.R. KING