


T.13S. R.10W. W.M.

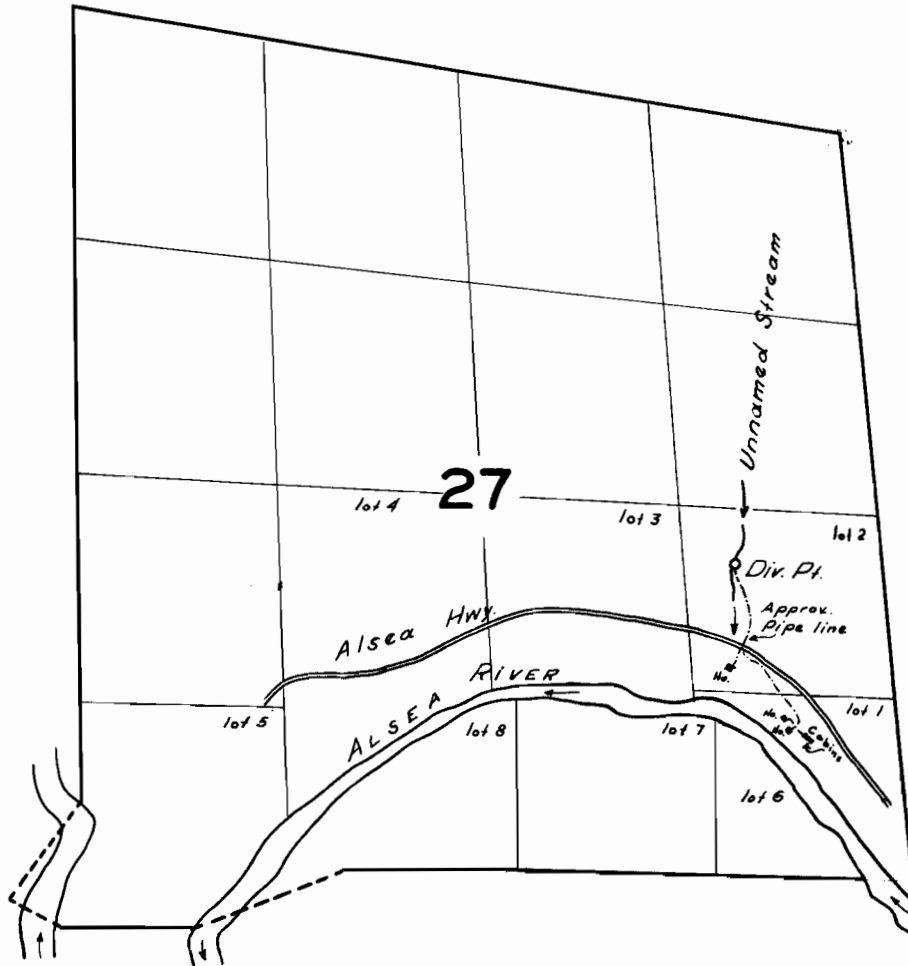

**FINAL PROOF SURVEY**  
UNDER

Application No. 24400 Permit No. 20187  
IN NAME OF

Mrs Guy A. Cox & Marvin B. & Eval. Noble

Surveyed 17 June 1957, by [Signature]