


T.13S.,R.1E.,W.M.

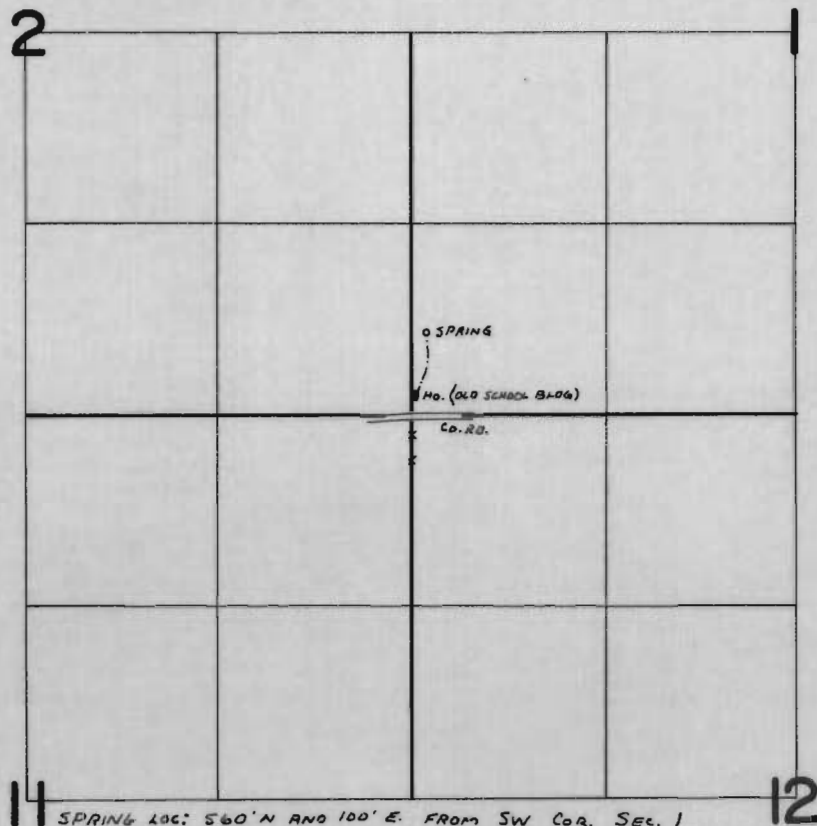

FINAL PROOF SURVEY
UNDER

Application No. 49820 Permit No. 37480
IN NAME OF

STEVEN A. & MARLENE STEIN

Surveyed JUNE 30 1975, by L. Tall