


T.30S., R.46E., W.M.

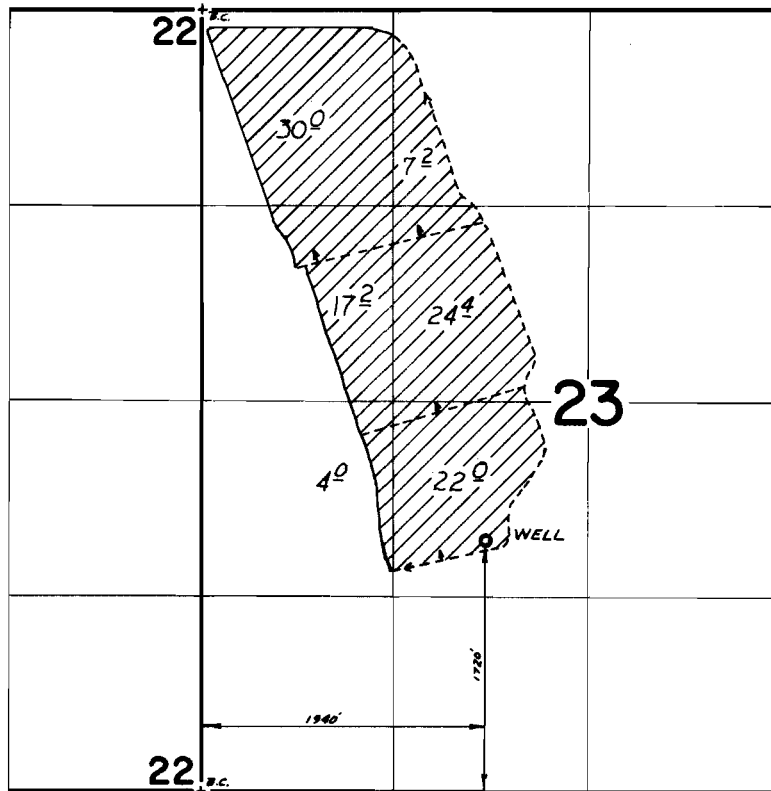

FINAL PROOF SURVEY
UNDER

Application No. G-3692 Permit No. G-3496
IN NAME OF

DONALD J. MCKAY

Surveyed July 17 1975, by D. Norby