


T.30S., R.46E., W.M.

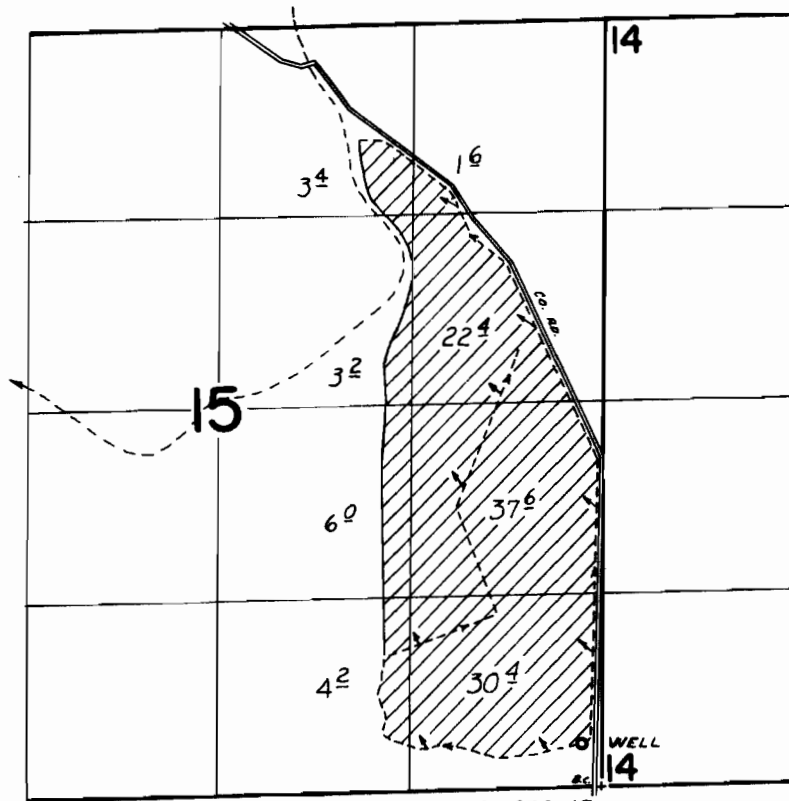

WELL LOC: 300' N & 140' W FROM SE COR. SEC. 15

FINAL PROOF SURVEY
UNDER

Application No. G-3676 Permit No. G-3450
IN NAME OF

JACA BROTHERS

Surveyed July 17 1975, by D. Norby