


T.6S.R.2W.W.M.

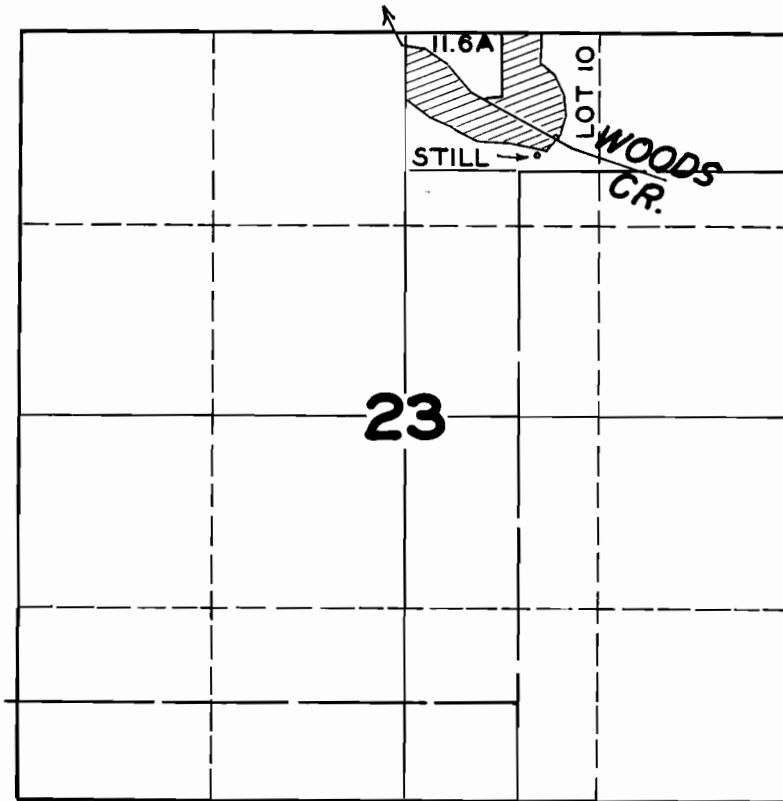

FINAL PROOF SURVEY

UNDER

Application No. 21073 Permit No. 16516

IN NAME OF

R. C. JEFFERSON

Surveyed APR. 29 1949, by JAS. E. BUNNELL