T. 1 N. R. 3 E. W.M.

DIV. PTS. LOC: UNNAMED STREAM #3 - 240'S & 1000'E;
UNNAMED STREAM #2 - 370'S & 1080'E;
SPRING AREA - 440'S & 1130'E;
SPRING #3 500'S & 700'E;
RESERVOIR 160'S & 930'E;
ALL FROM N.W. COR. MOLLOY D.L.C. 55

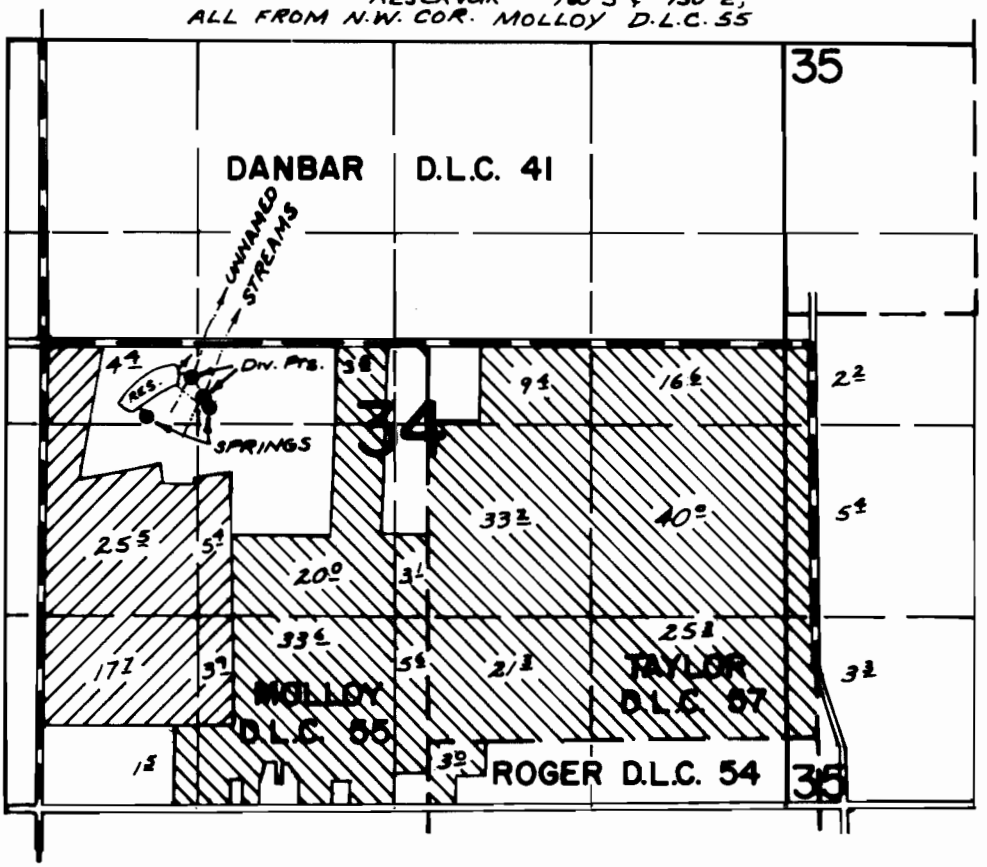

FINAL PROOF SURVEY
UNDER

Application No. R-50607 50608 50021 Permit No. R-5964 36772 36765

IN NAME OF

PETER K. McGILL

dba McGILL & SON

Surveyed AUG. 11 1976, by L. E. GOULD

R.G.M.
1976-L & DFQ - ILL-34