


# T. 1 N. R. 3 E. W. M.

DN. PTS. LOC: UNNAMED STREAM<sup>1</sup> - 240' S & 1000' E;  
 UNNAMED STREAM<sup>2</sup> - 370' S & 1080' E;  
 SPRING AREA - 440' S & 1130' E;  
 SPRING<sup>3</sup> - 500' S & 700' E;  
 RESERVOIR - 160' S & 930' E;  
 ALL FROM N.W. COR. MOLLOY D.L.C. 55

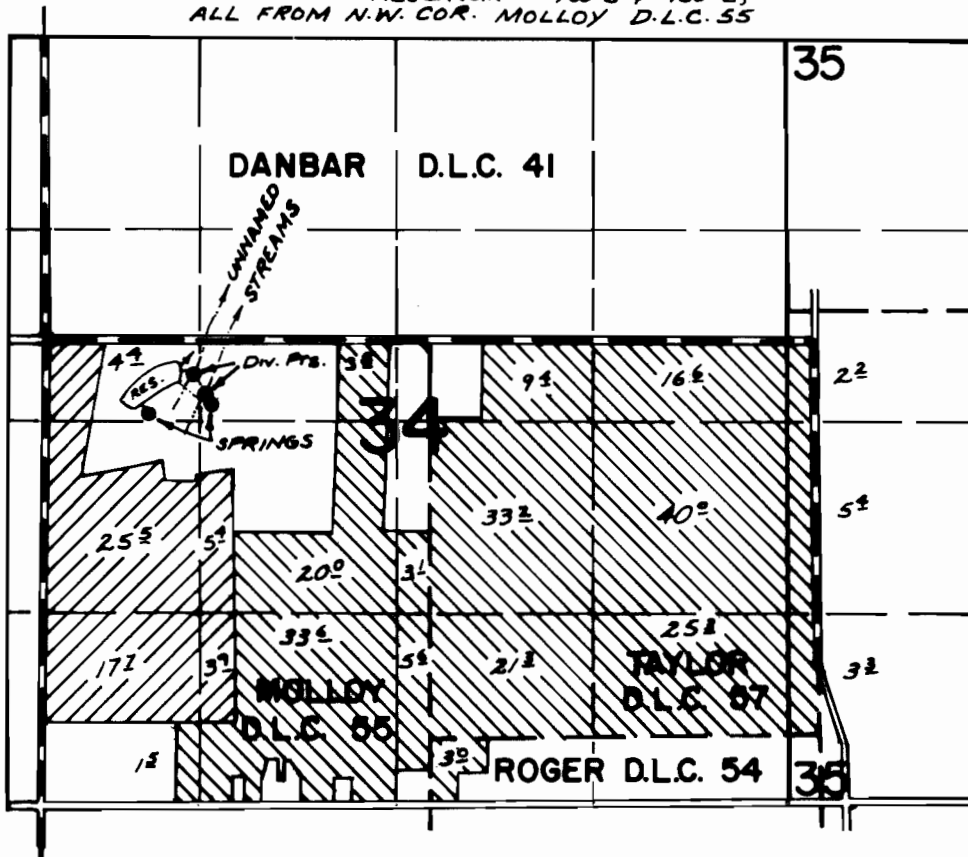

## FINAL PROOF SURVEY UNDER

R-50607                      R-5964  
 50608                      36772  
 Application No. 50221      Permit No. 36765

IN NAME OF

PETER K. MCGILL  
 dba. MCGILL & SON

Surveyed AUG. 11, 1976, by L. E. GOULD