


T.10S., R.7W., W.M.

Sec.11

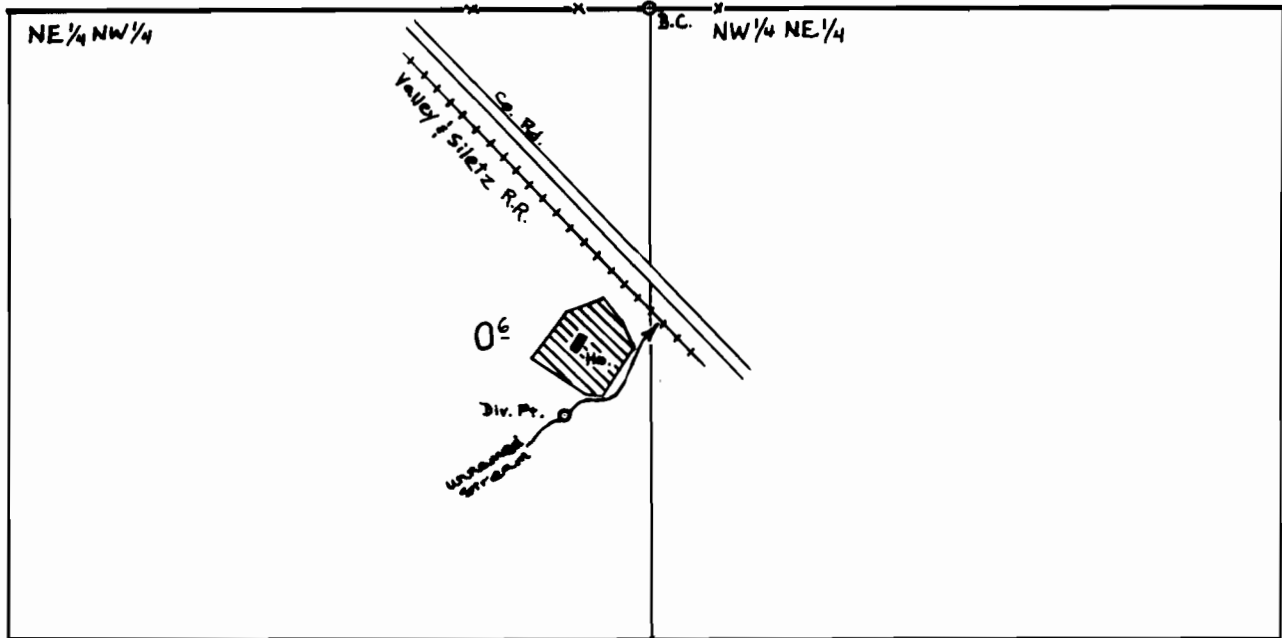

Div Pt. Located: 350' S & 100' W from N 1/4 cor. Sec. 11

SCALE: 1" = 400'

**FINAL PROOF SURVEY**  
UNDER

Application No. 46673 Permit No. 34869  
IN NAME OF

ALBERT E. CLAREMONT

Surveyed OCT. 7 1976, by C.R. KING