


T.9S. R.4W. W.M.

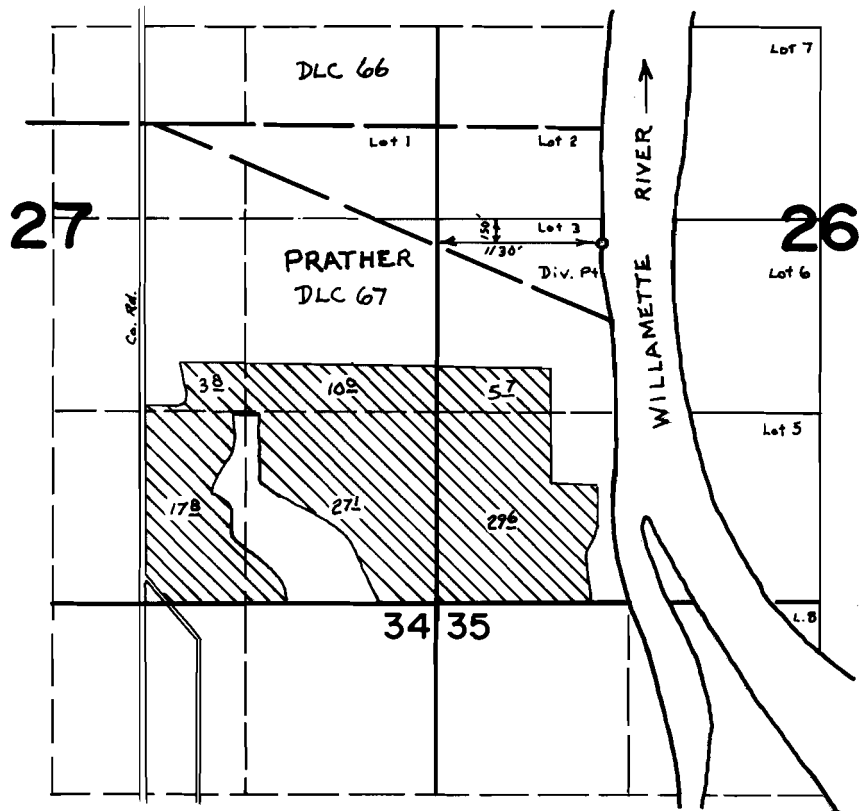

FINAL PROOF SURVEY UNDER

Application No. 50408. Permit No. 38043.
IN NAME OF

MRS. BLANCHE RUST

Surveyed MAY 19, 1976, by C.R. KING