


T. 6 N., R. 35 E., W. M.

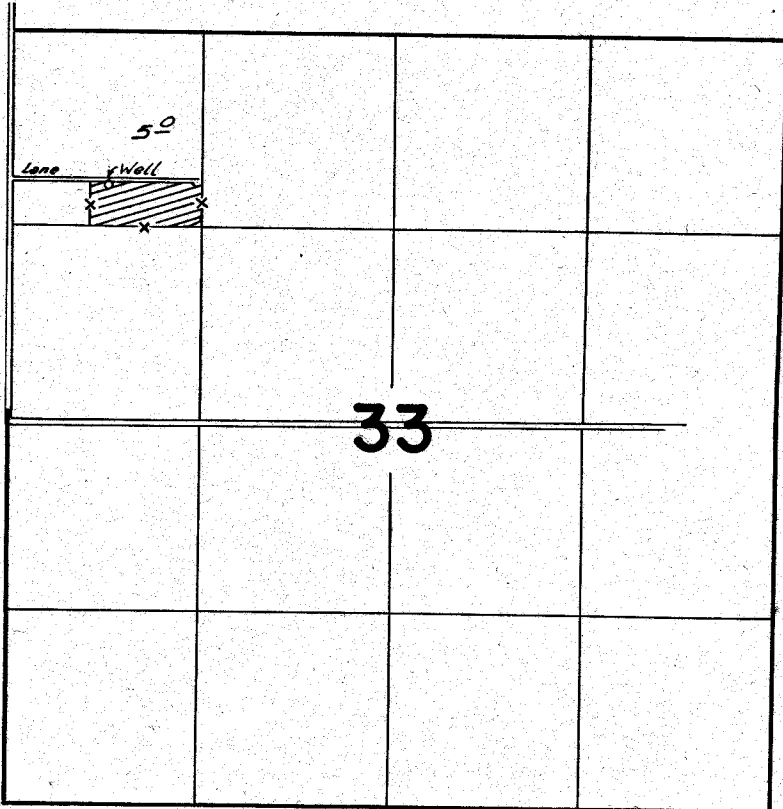

Well Loc.: 1050'S., 680'E. from NW Cor. Sec. 33

FINAL PROOF SURVEY UNDER

Application No. G-5997 Permit No. G-5731
IN NAME OF

William W. Widner

Surveyed Apr. 7, 1976 by C. R. King