


T.4N.,R.34E.,W.M.

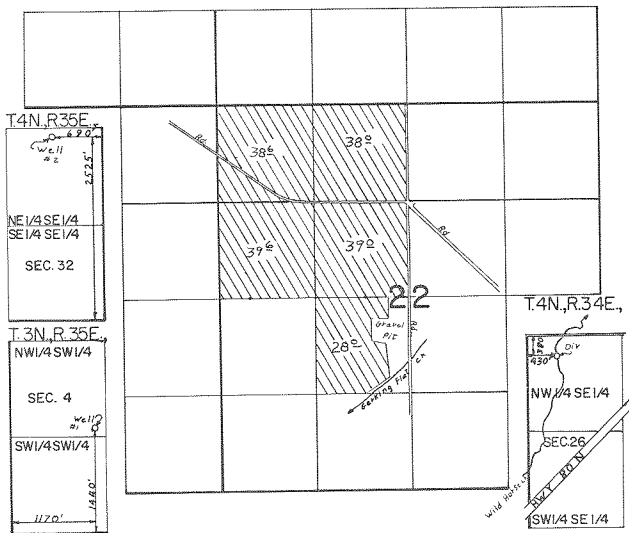

FINAL PROOF SURVEY UNDER

Application No. G-6371 51545 Permit No. G-5966 38766
IN NAME OF

JOHNS, SMITH & BEAMER

Surveyed APRIL 14, 1976., by C.R. KING