


T.1S.,R.32E.,W.M.

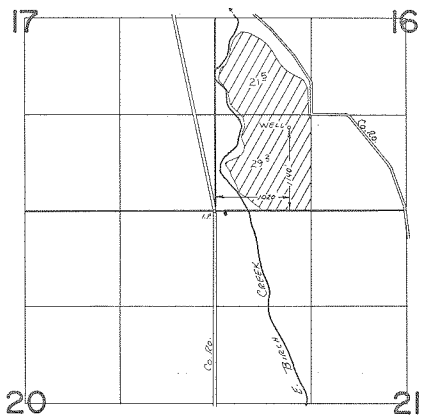

FINAL PROOF SURVEY UNDER

Application No. G-6638 Permit No. G-6000
IN NAME OF

RAY SLABIK

Surveyed APRIL 14, 1976, by L. T. Tolson