


G-6326

L18438

T.4N.,R.35E.,W.M.

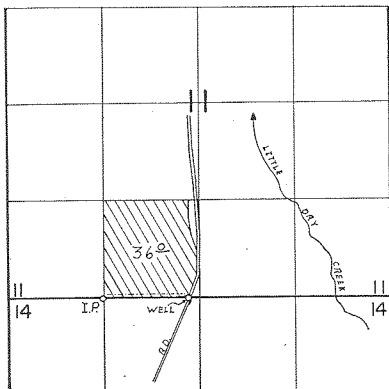

WELL: 180' W. OF S 1/4 COR SEC. 11

FINAL PROOF SURVEY UNDER

Application No. G-6832 Permit No. G-6326
IN NAME OF

GEORGE R. WINN

Surveyed APRIL 13, 1976, by C.R. KING