


G-6075
45439

T.6N., R. 35E., W.M.

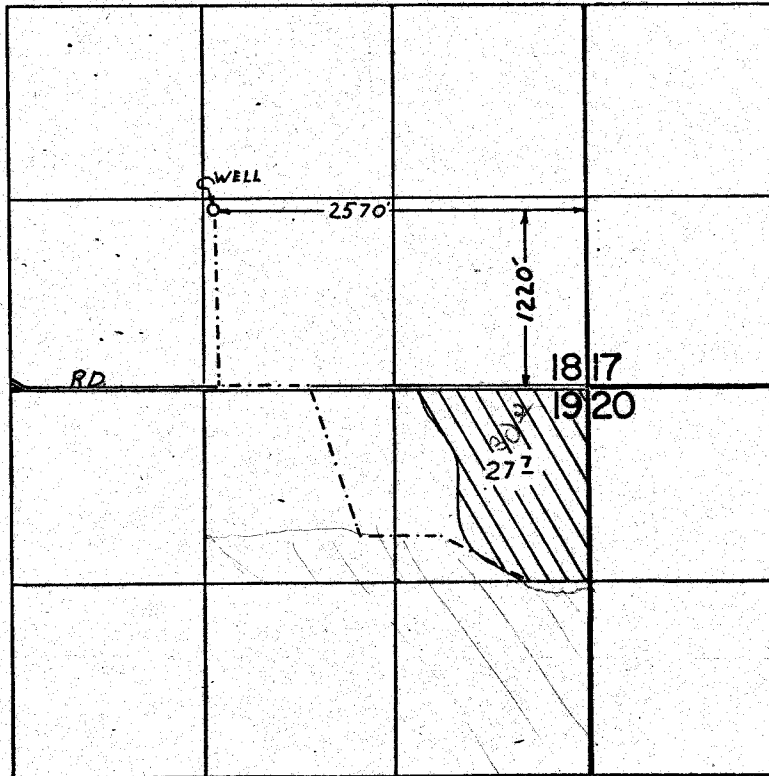

FINAL PROOF SURVEY
UNDER

Application No. G-6974 Permit No. G-6075
IN NAME OF

DOTTIE CHRISTENSON

Surveyed APRIL 8, 1976, by C.R. KING