


T.6N.,R.34E.,W.M.

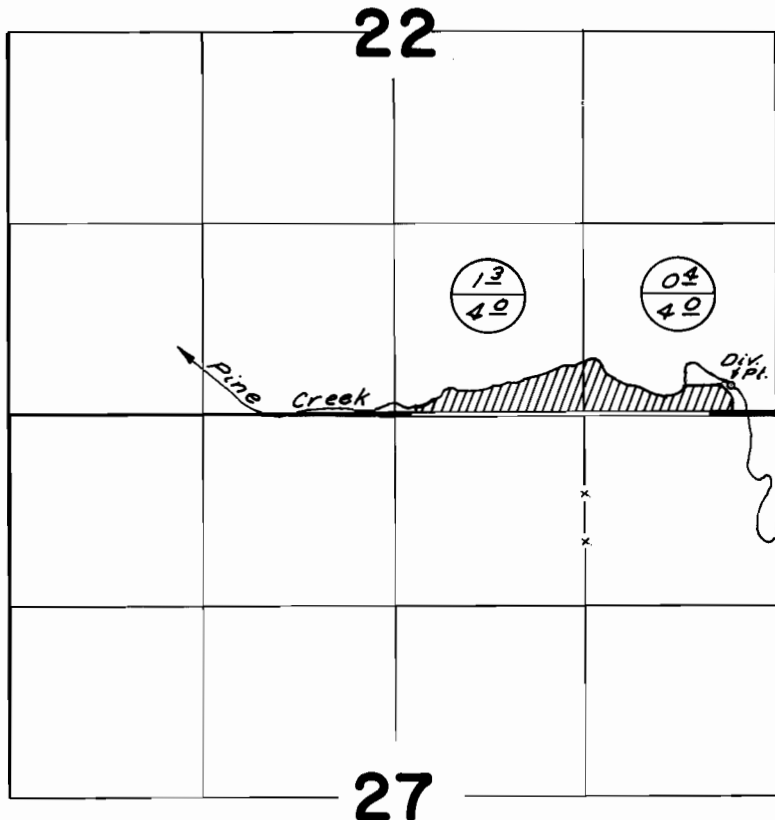

Div. Pt. Loc.: 180' N. & 330' W. from SE Cor. Sec. 22

$\frac{0^{\circ}}{0^{\circ}}$ Primary
Suppl.

FINAL PROOF SURVEY UNDER

Application No. 48058 Permit No. 36036
IN NAME OF

Michael Troyer

Surveyed Apr. 10, 1976 by C.R. King