


# T.4N.,R.34E.W.M.

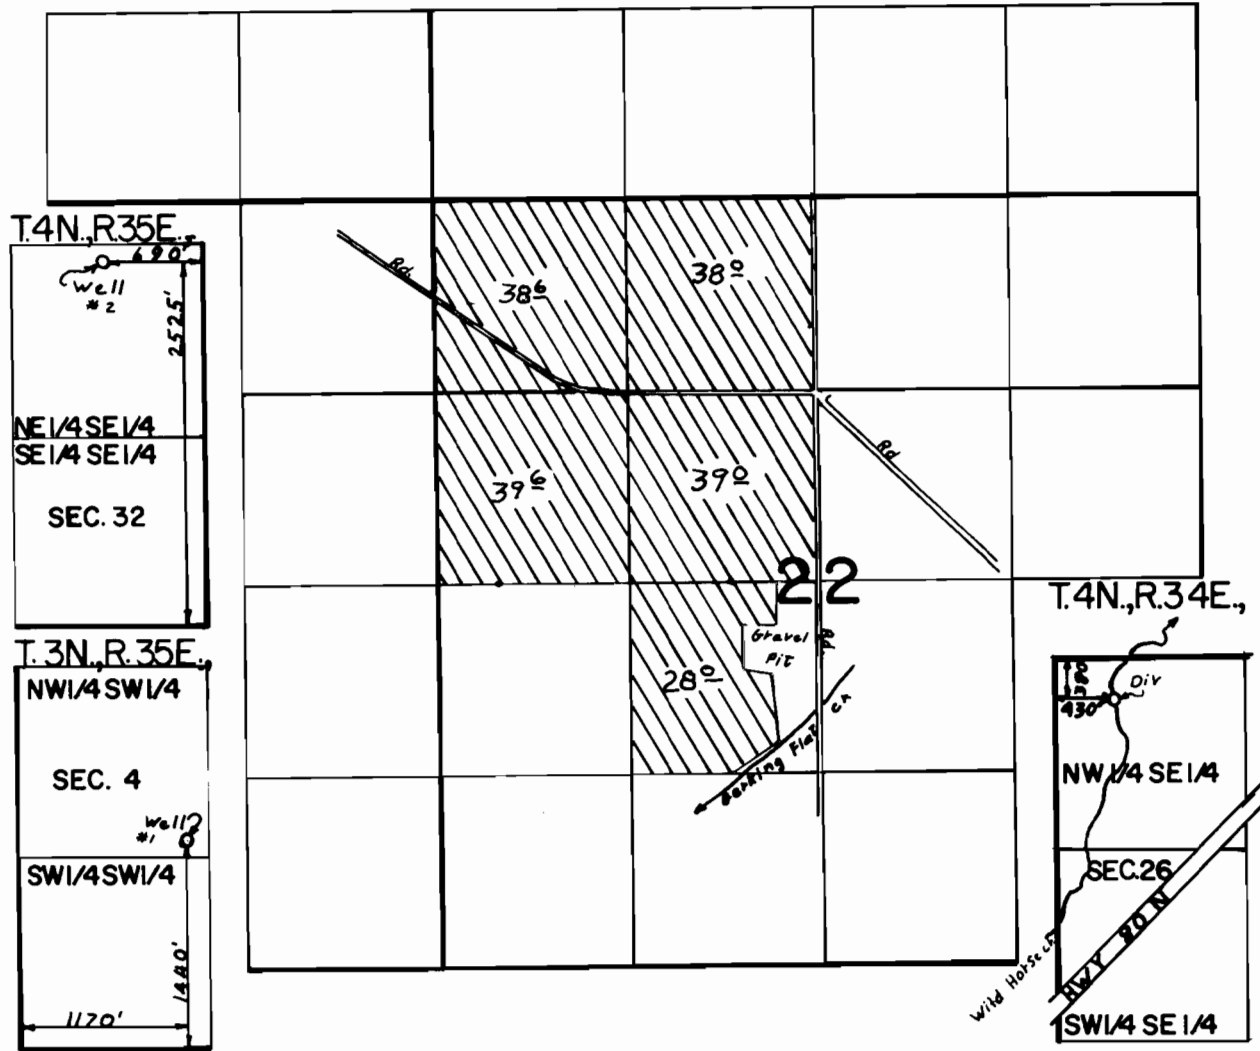

## FINAL PROOF SURVEY UNDER

Application No. G-6371 51545 Permit No. G-5966 38766  
IN NAME OF

JOHNS, SMITH & BEAMER

Surveyed APRIL 14, 1976, by C.R. KING