


T.6 N. R. 35 E. W.M.

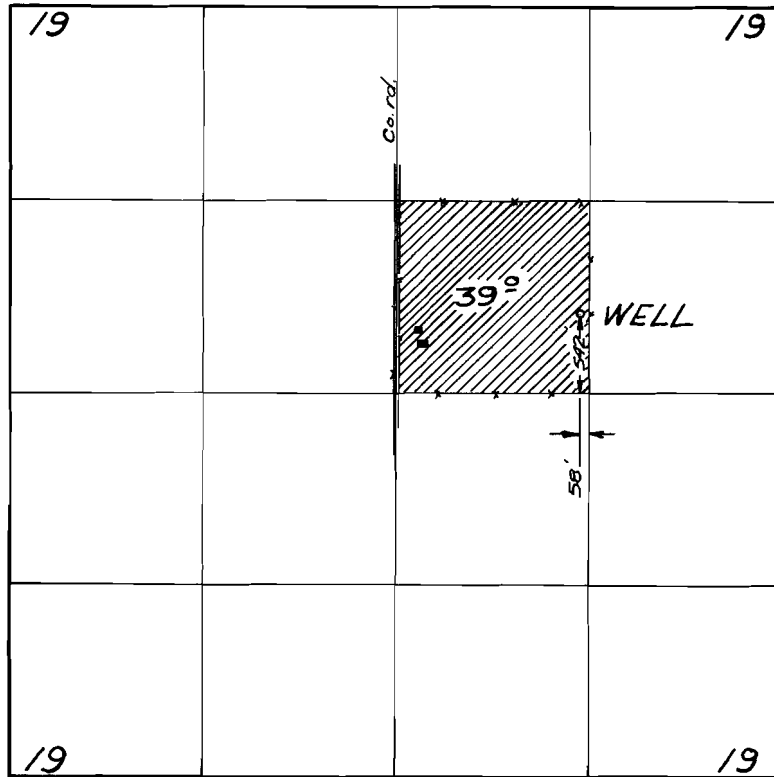

**FINAL PROOF SURVEY**  
UNDER

Application No. G-2882 Permit No. G-2674  
IN NAME OF

LOUIS SWEARINGEN

Surveyed Oct. 27, 1966, by V. GARNER