


# T.2S.R.3 & 4W.W.M.

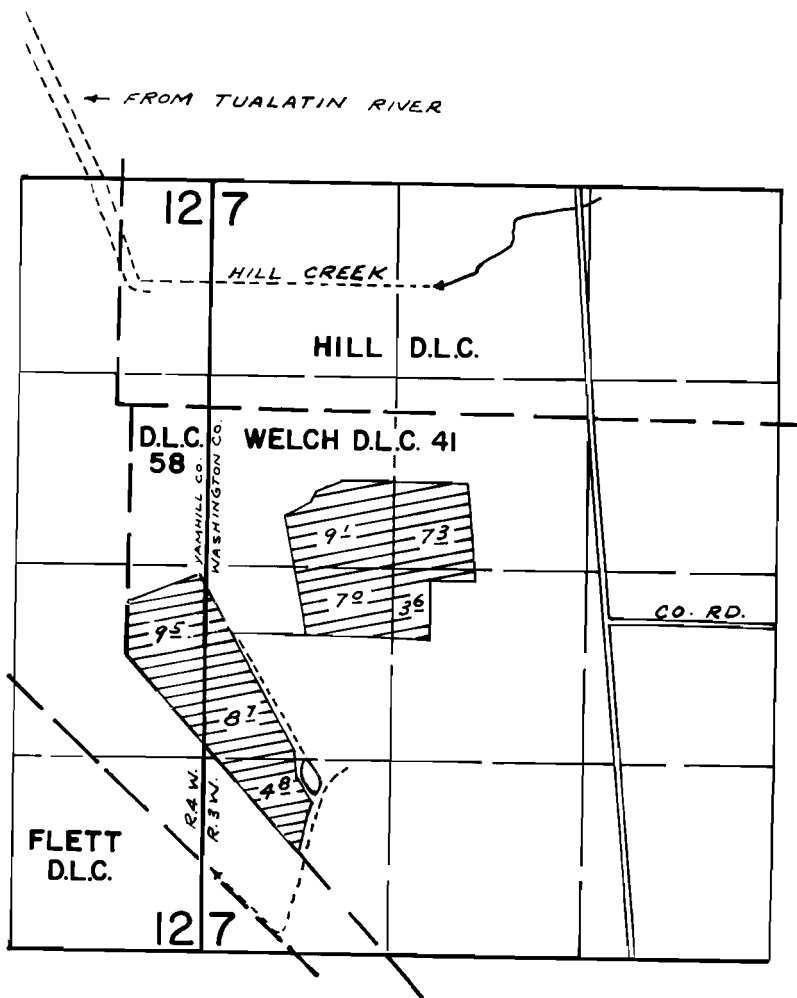

DIV. PTS. LOC: HILL CR. - NW $\frac{1}{4}$ NW $\frac{1}{4}$ , NE $\frac{1}{4}$ NW $\frac{1}{4}$  SEC. 7, T. 2S. R. 3W  
 NE $\frac{1}{4}$ NE $\frac{1}{4}$  SEC. 12 T. 2S. R. 4W. ; TUALATIN RIVER - NW $\frac{1}{4}$ SW $\frac{1}{4}$   
 SEC. 36 T. 1S. R. 4W

## FINAL PROOF SURVEY UNDER

TRANSFER K-18

Application No. .... Permit No. ....  
 IN NAME OF

JOHN W. KOPPLIN

Surveyed APRIL 4 1956, by R. D. BEST  
 REVISED MARCH 23, 1978