


45453
45454

T. 8S. R. 24E. W.M.

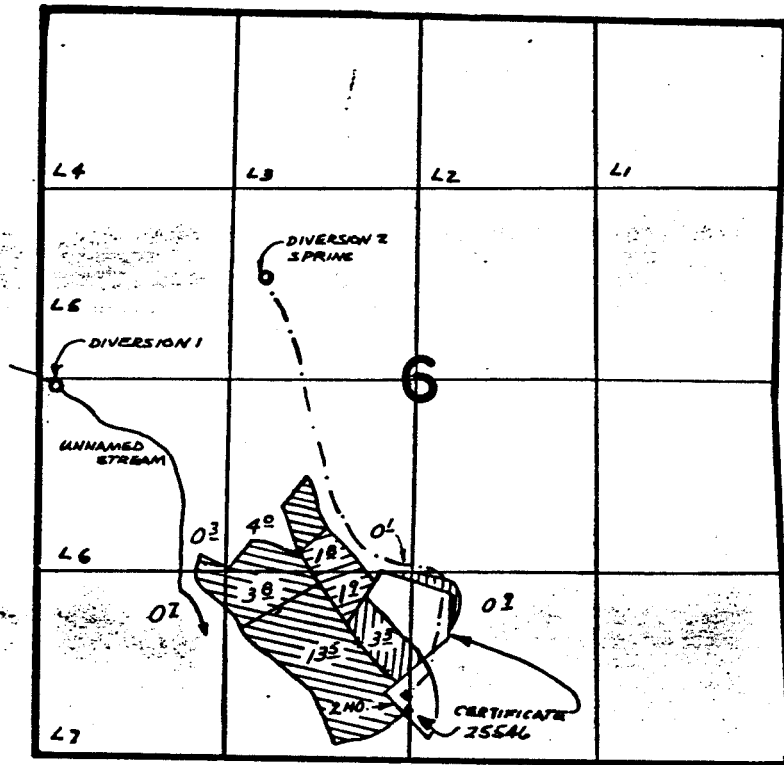

DIVERSION 1 LOCATED 2600' S. & 110' E. FROM NW COR SEC 6
 DIVERSION 2 LOCATED 1920' S. & 1540' E FROM NW COR SEC 6

APPL. 51613 → STREAM

APPL. 46060 → STREAM → STREAM & SPRING

FINAL PROOF SURVEY UNDER

51613 37396

Application No. 46060. Permit No. 34499

IN NAME OF

THOMAS L. LANDWEER & DONALD McQUINN

..... DONALD & ELMER McQUINN

Surveyed AUG. 25. 1977. by R.G. MUCKEN