


48453  
48454

# T. 8S. R. 24E. W.M.

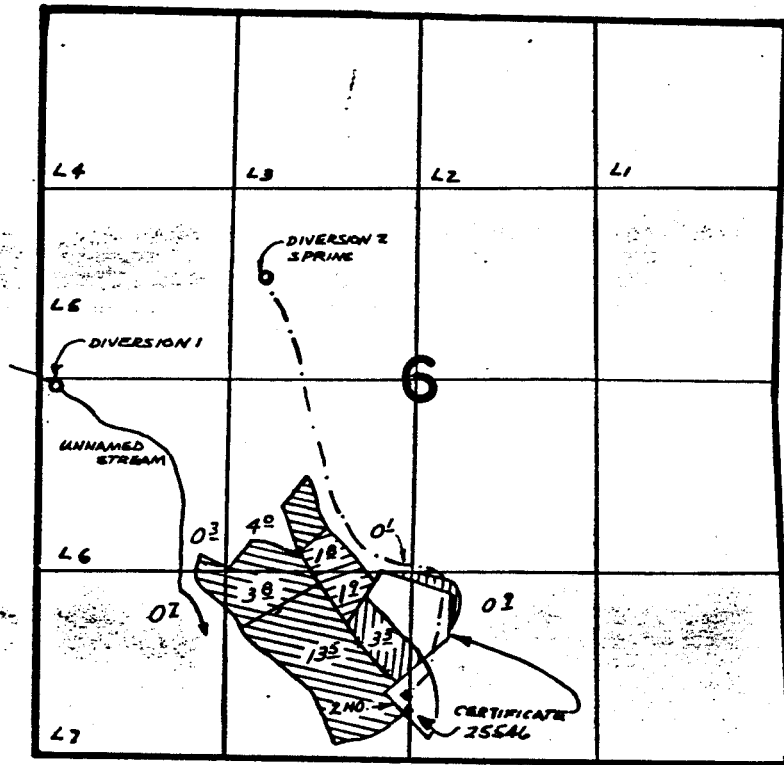

DIVERSION 1 LOCATED 2600' S. & 110' E. FROM NW COR SEC 6  
 DIVERSION 2 LOCATED 1920' S. & 1540' E FROM NW COR SEC 6

APPL. 51613 → STREAM

APPL 46060 → STREAM      → STREAM & SPRING

## FINAL PROOF SURVEY UNDER

51613                      37396

Application No. 46060. Permit No. 34499

IN NAME OF

THOMAS L. LANDWEER & DONALD McQUINN

..... DONALD & ELMER McQUINN .....

Surveyed AUG. 25. 1977. by R.G. MUCKEN