


T.15S. R.5W.W.M.

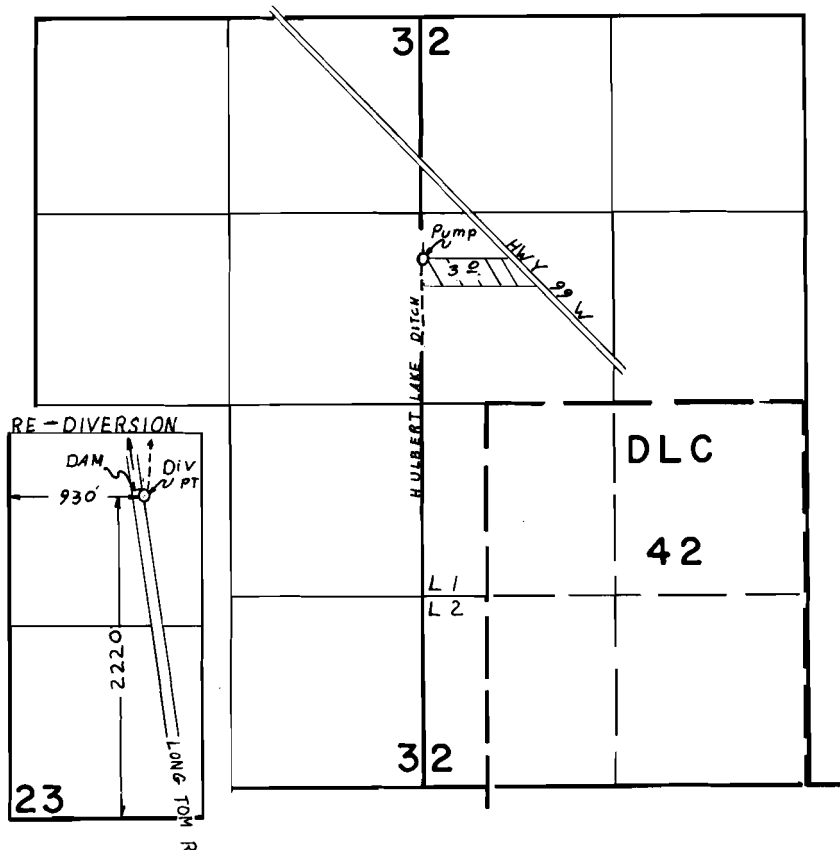

FINAL PROOF SURVEY
UNDER

Application No. 50624 Permit No. 39121
IN NAME OF

CARL RIECKE

Surveyed OCT. 5, 1976, by C.R. KING