


T.10S.,R.7W.,W.M.

SEC. 12

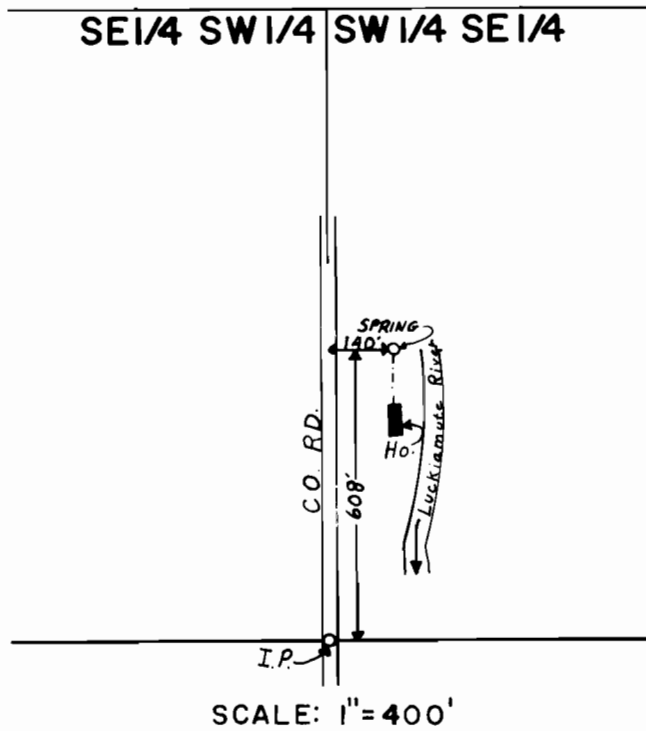

FINAL PROOF SURVEY
UNDER

Application No. 51025 Permit No. 38511
IN NAME OF

JAMES GLEN & VIOLET M. COOPER

Surveyed JULY 9 1976, by C.R. KING