


T.12S.,R.6W.,W.M.

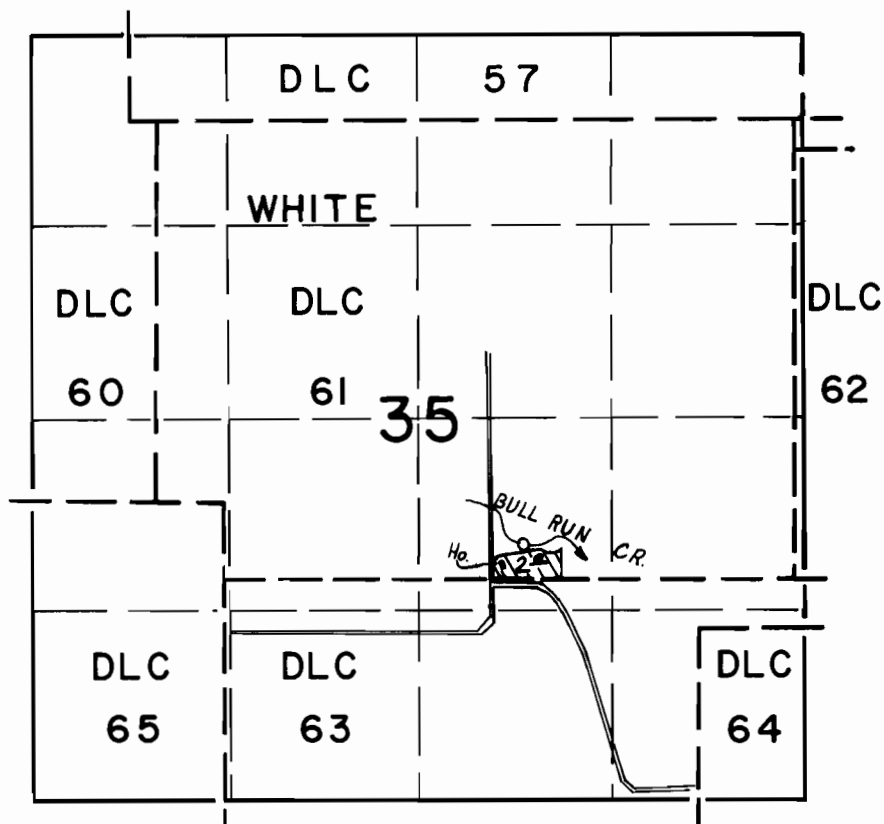

DIV: 250' N & 1860' W FROM SE. COR DLC 61

FINAL PROOF SURVEY
UNDER

Application No. 51328 Permit No. 38753
IN NAME OF

EVERETT & CHARLOTTE MANES

Surveyed JULY 7, 1976, by C. R. KING