


T.5 S. R.1 E. W.M.

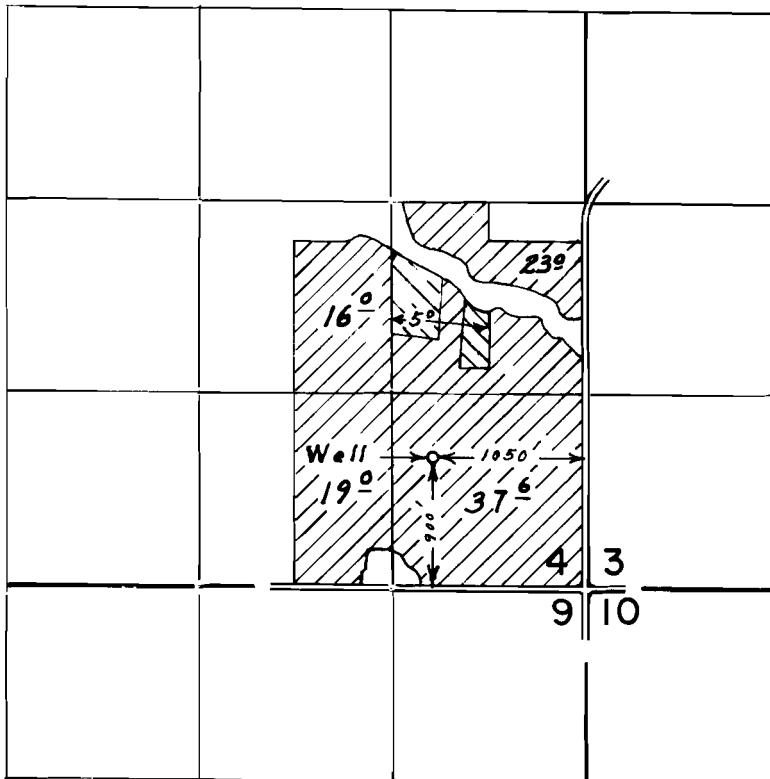

Primary
Supplemental



FINAL PROOF SURVEY

UNDER

Application No. G-5218 Permit No. G-5079
IN NAME OF _____

BILL L. ROSE

Surveyed May 17, 1976, by L. E. Gould