


T.3 S. R.I.E. W.M.

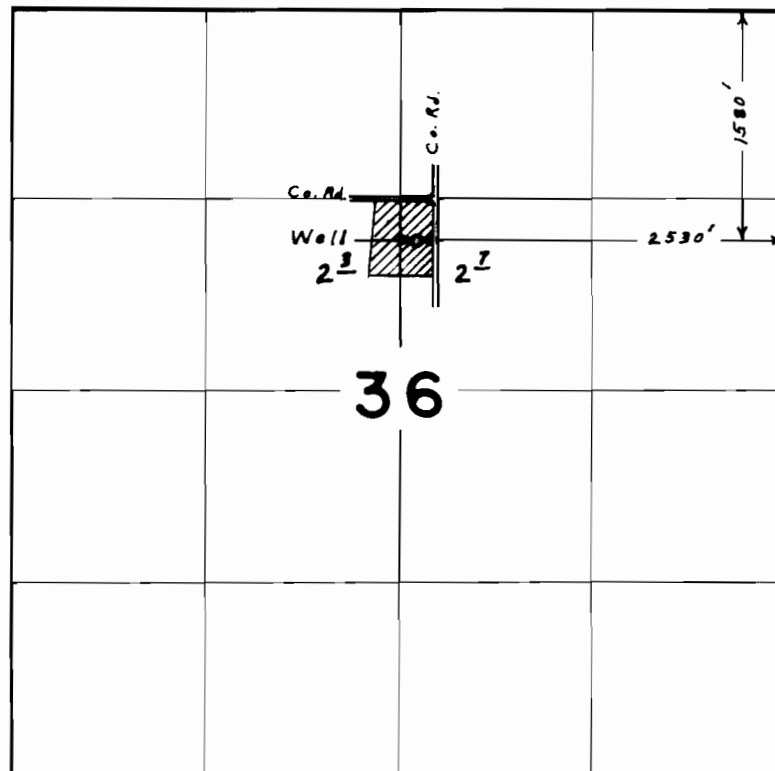

FINAL PROOF SURVEY
UNDER

Application No. G-5886 Permit No. G-5704
IN NAME OF

T. W. BECKMAN

Surveyed April 22, 1976, by L. E. Gould