


T.3 S. R.1 E. W.M.

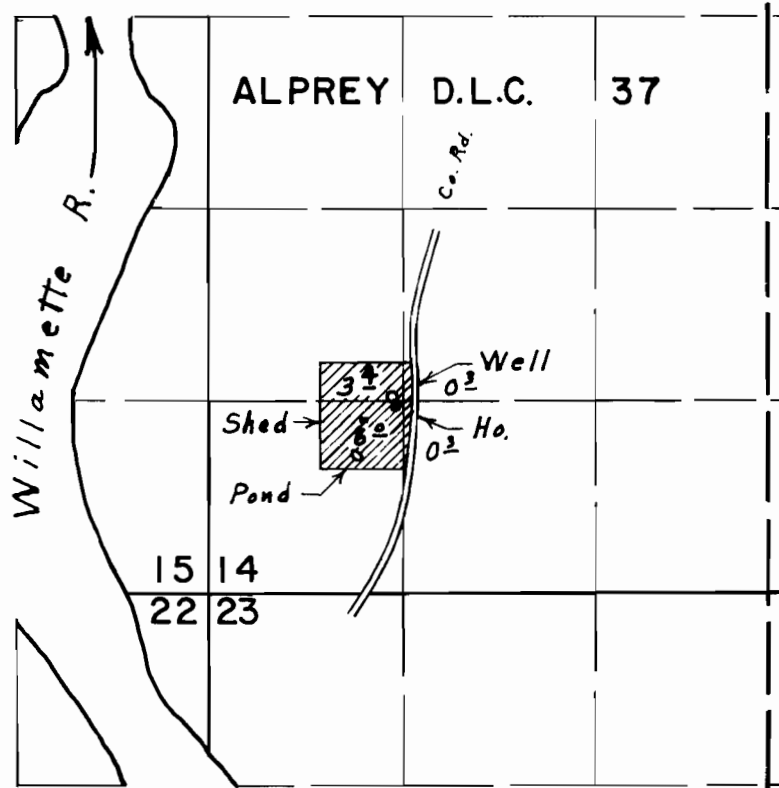

Well located 1350' N. & 1260' E. from S.W. Cor. Sec. 14

FINAL PROOF SURVEY UNDER

Application No. G- 6322 Permit No. G-5936
IN NAME OF

GEORGE & CATHERINE MILLER

Surveyed April 21, 1976, by L. E. Gould.