


# T.2 S. R.6 E. W.M.

CHANGED TO

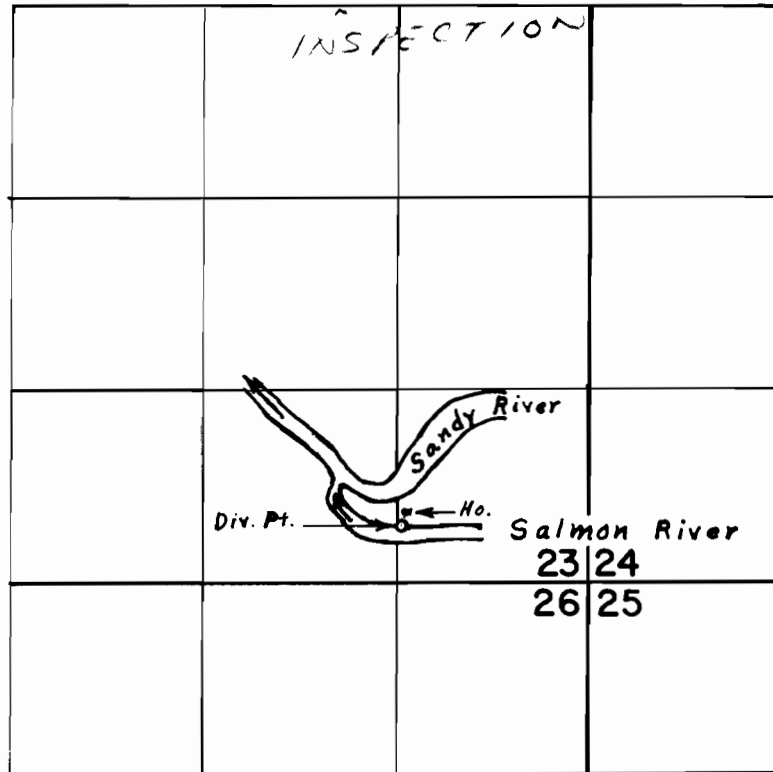

Div. Pt. located 390' N. & 1290' W. from S. E. Corner Sec. 23

## FINAL PROOF SURVEY UNDER

Application No. 50755. Permit No. 37430.  
IN NAME OF

**WILLIAM H. & BARBARA A. WHITE**

Surveyed Oct. 15, 1975, by L. E. Gould.

76  
Change to inspection