


T.5N., R.7 W., W.M.

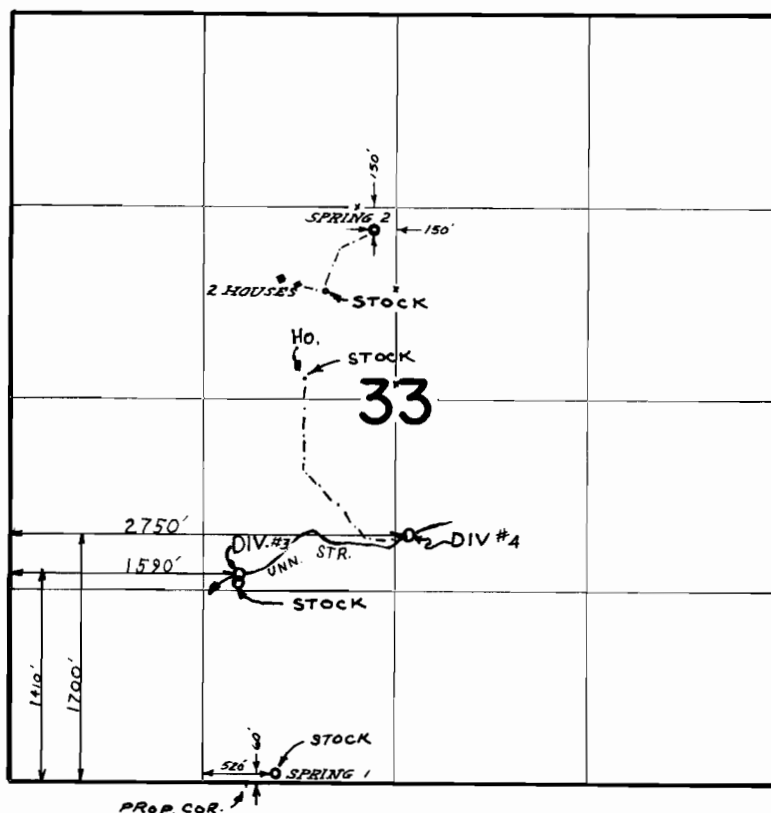

FINAL PROOF SURVEY
UNDER

Application No. 42390 Permit No. 31735
IN NAME OF

JOHN J. DOONEY

Surveyed SEPT 15 76 by C. R. KING
June 6 1974 by D. Norby