


T.4N., R.7W., W.M.

SEC. 4

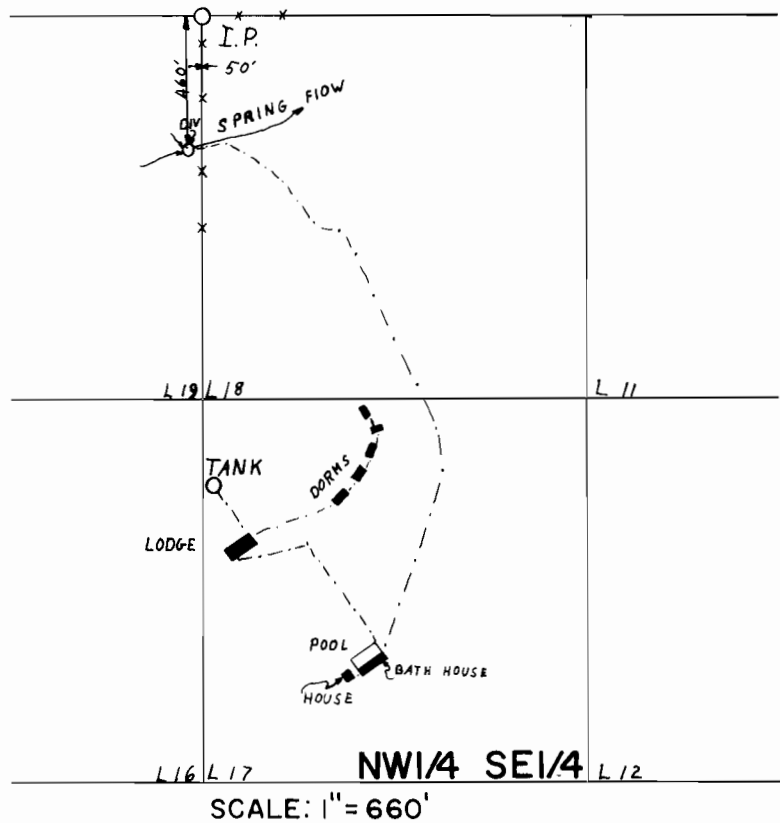

**FINAL PROOF SURVEY**  
UNDER

Application No. 49095 Permit No. 35937  
IN NAME OF

OSWALD C. SVEHAUG

Surveyed SEPT. 15. 1976. by G.R. KING.