


RECEIVED  
JUL 23 1973  
STATE ENGINEER  
SALEM OREGON

RECEIVED  
JUL 16 1973  
STATE ENGINEER  
SALEM OREGON

WATER RIGHT - TED & RUBY LANNIGAN.  
Gov't Lots 13 } SEC. 9, TAN, R 8 W  
11 }  
CLATSOP COUNTY. SCALE 1" = 200'

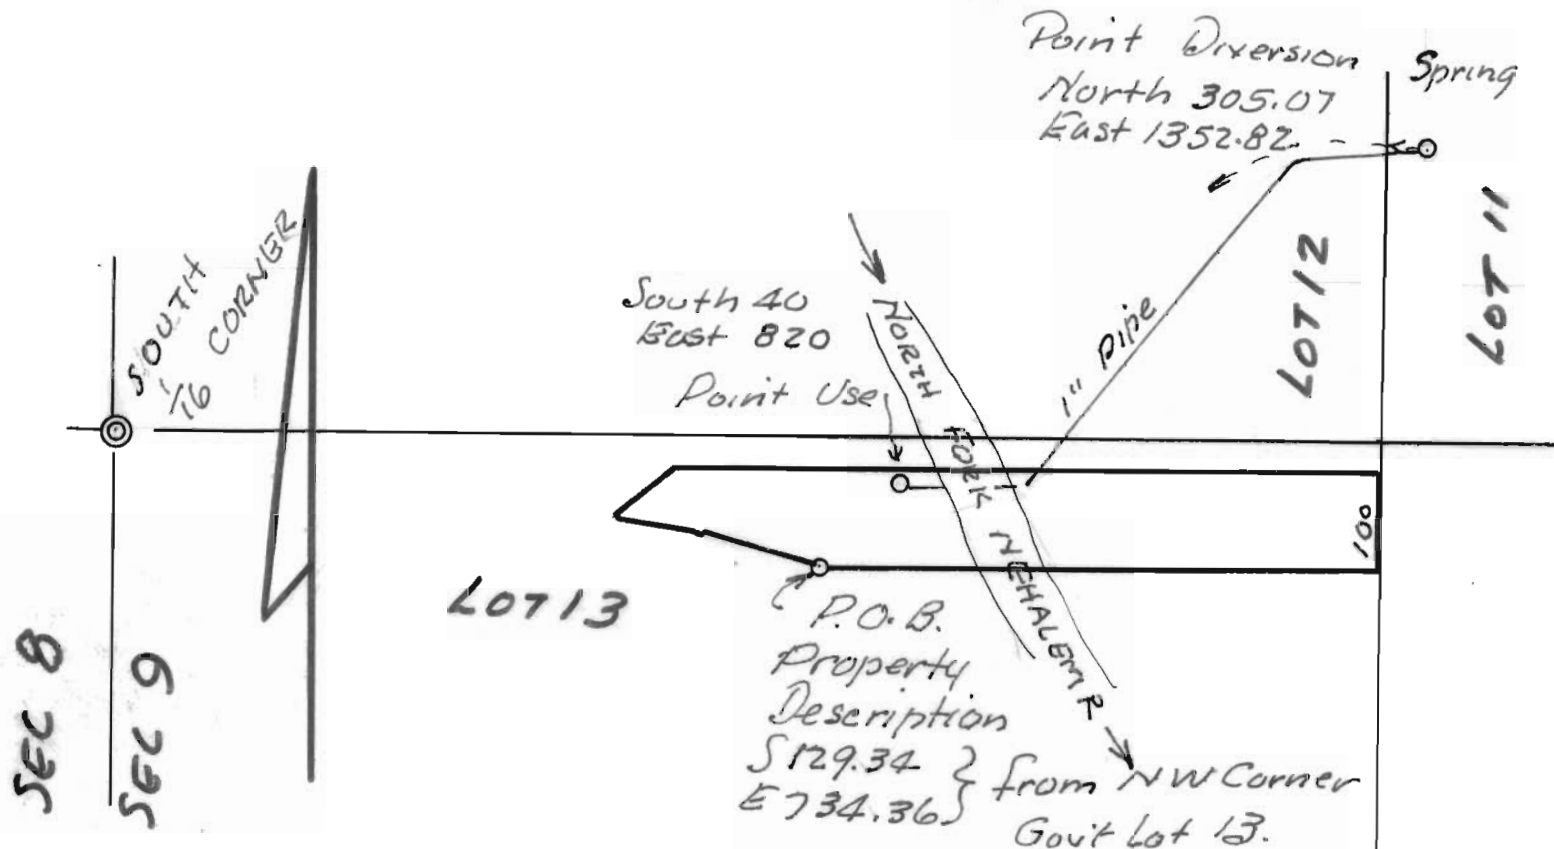

SURVEYOR'S CERTIFICATE:

I, W. A. MARKHAM, Registered Engineer No. 1842, hereby certify that this map is made from notes of an actual survey made by me on July 7, 1973.

*W. A. Markham*



Application No. 50931  
Permit No. 38452