


T.29S. R.14W. W.M.

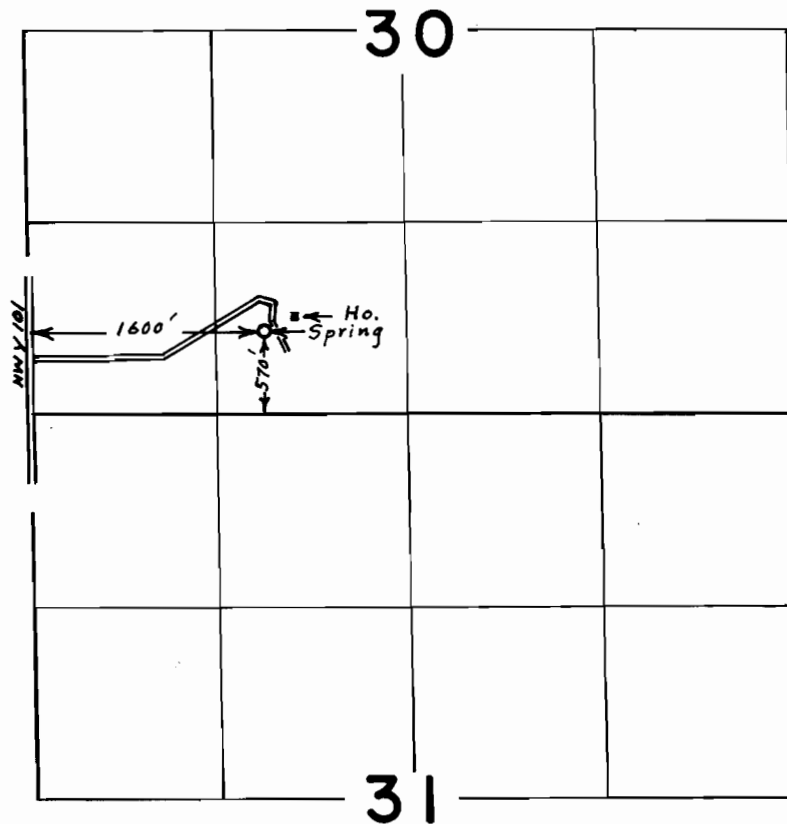

FINAL PROOF SURVEY
UNDER

Application No. 47567 Permit No. 35614
IN NAME OF

KNUD N. & EMMY N. JENSEN

Surveyed Aug. 28, 1976, by L. E. Gould