


T.28S. R.14W. W.M.

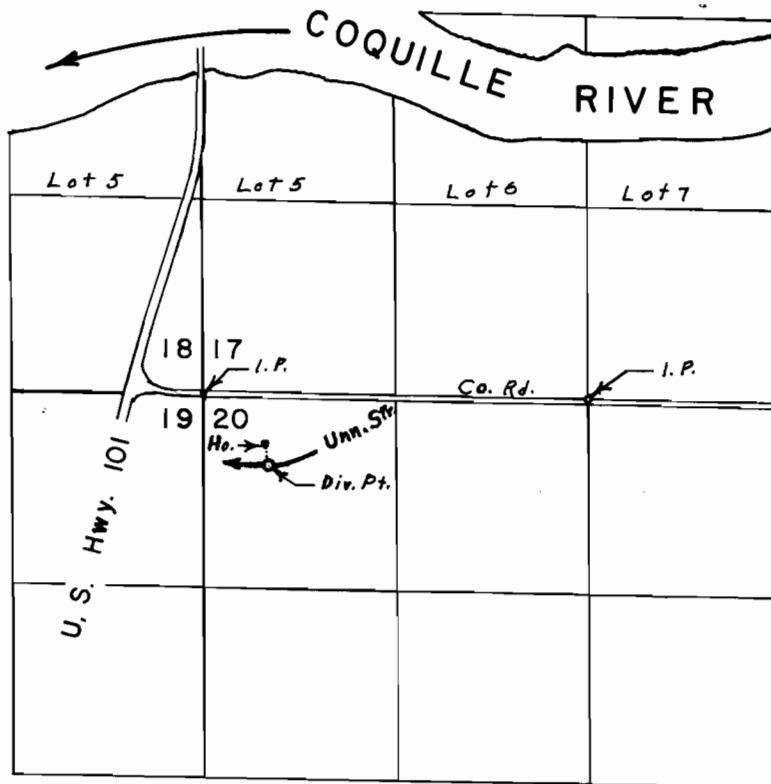

Div. located 500' S. & 440' E. from N.W. Corner Section 20

FINAL PROOF SURVEY
UNDER

Application No. 48066 Permit No. 35958
IN NAME OF

THOMAS J. STINNETT

Surveyed July 16, 1976, by L. E. Gould