


# T.26&27S. R.14W. W.M.

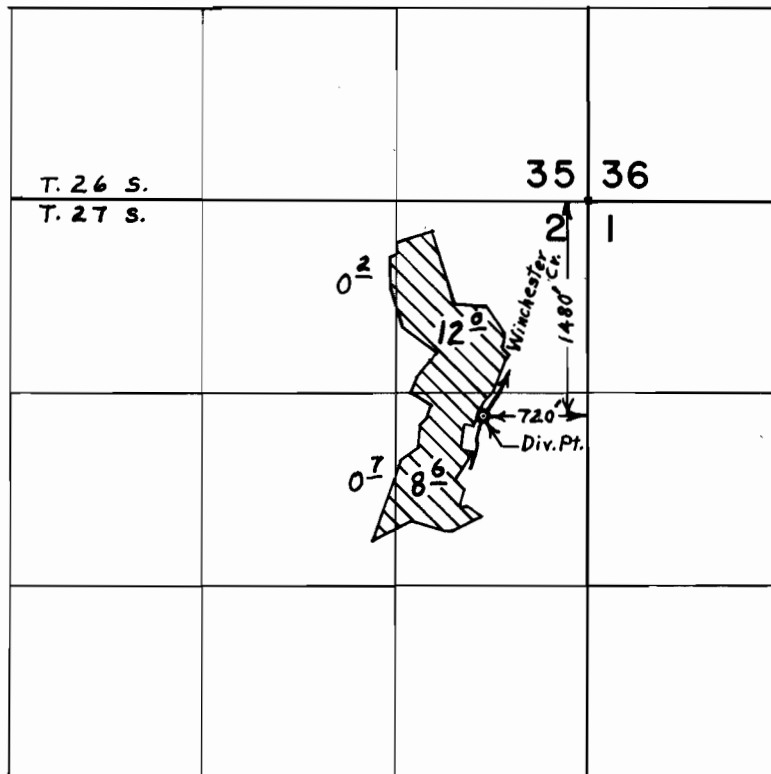

## FINAL PROOF SURVEY UNDER

Application No. 48091 Permit No. 36115  
IN NAME OF  
CLYDE E. DEAL

Surveyed Aug. 26, 1976, by L. E. Gould