


T.27S., R.2W., W.M.

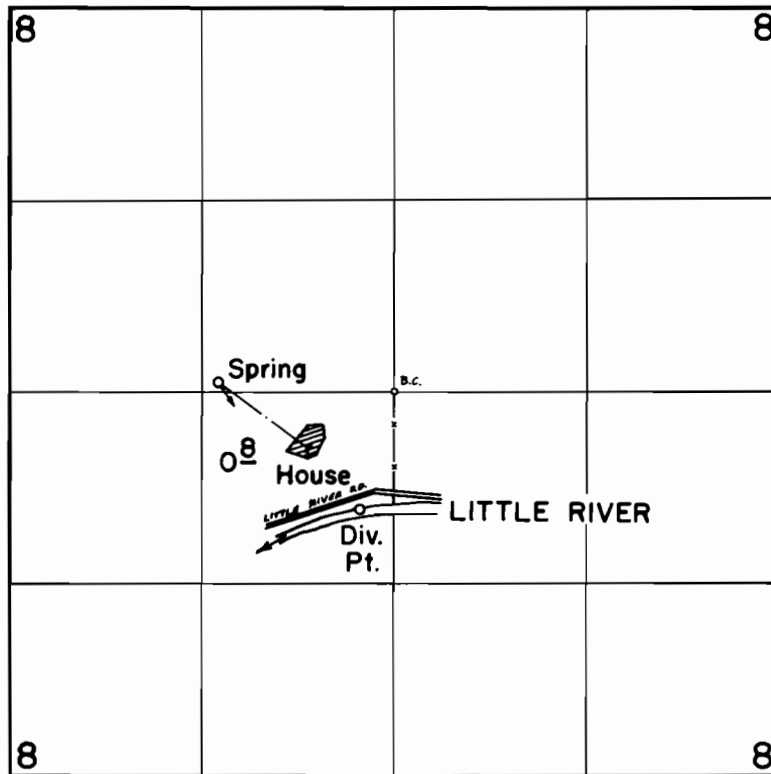

DIV. PTS. LOC: SPR.- 70' N & 1200' W; STR.- 800' S & 230' W BOTH FROM CENTER SEC. 8

FINAL PROOF SURVEY
UNDER

Application No. 50251 Permit No. 37497
IN NAME OF

JAMES & BETTE JUNE SUMMERS

Surveyed April 9 1976, by D. Norby