


T.28S., R.8W., W.M.

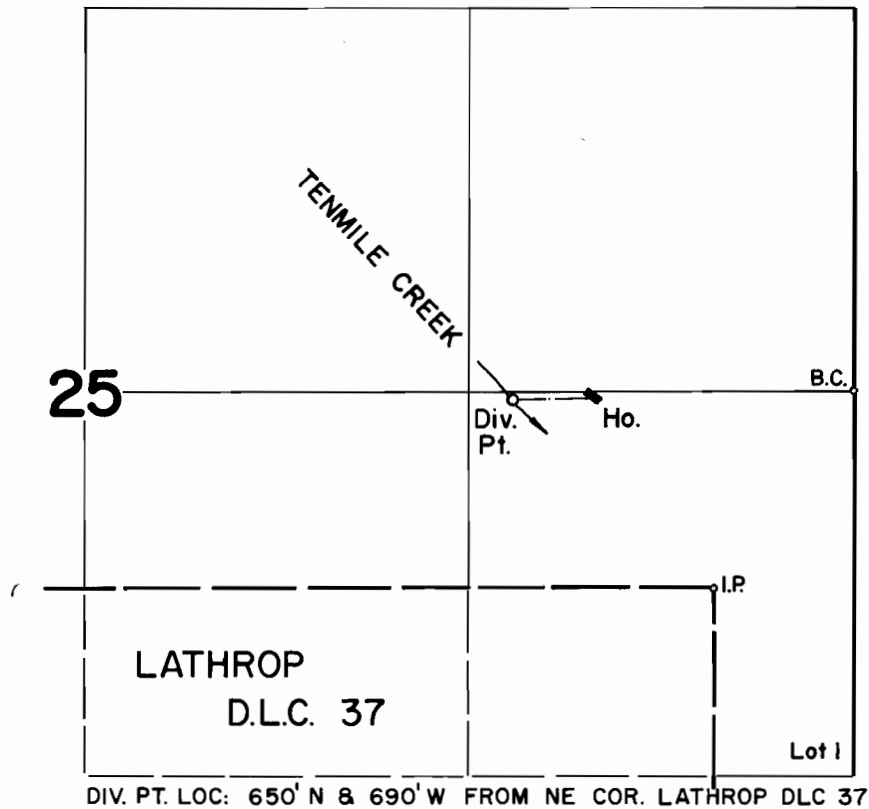

Scale: 1" = 660'

FINAL PROOF SURVEY UNDER

Application No. 50314 Permit No. 37988
IN NAME OF

LAWRENCE E. WAGEMAN

Surveyed Oct. 14 1976, by D. Norby