


T.29S. R.5 W. W.M.

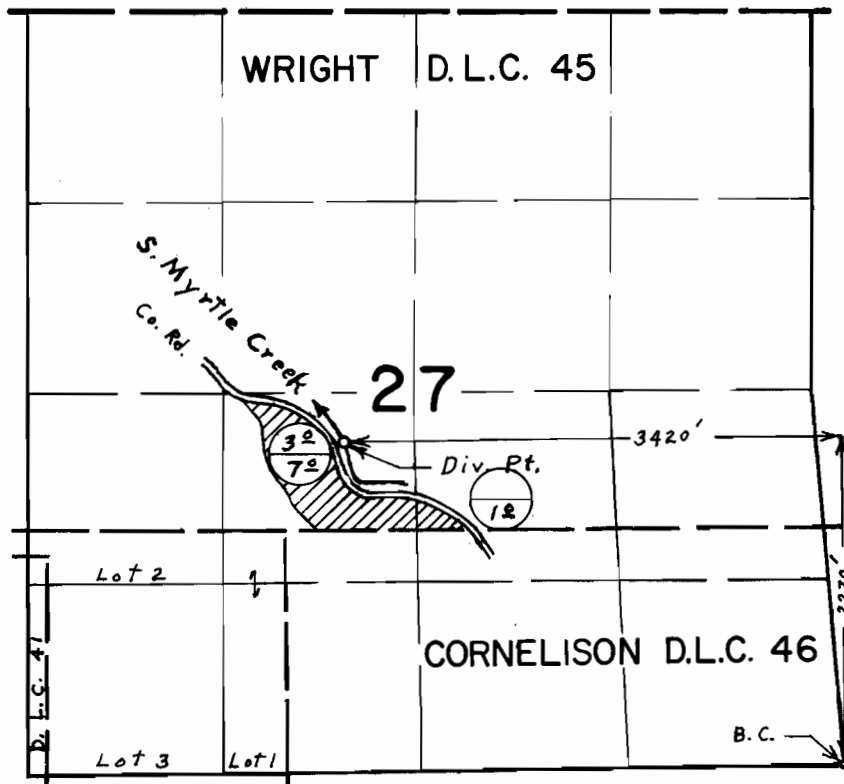

PERMIT 8054
PERMIT 38468



FINAL PROOF SURVEY
UNDER

Application No. 50960 Permit No. 38468
IN NAME OF

LEONARD DYER

Surveyed May 14, 1976, by L. E. Gould