


T.29S. R.4W. W.M.

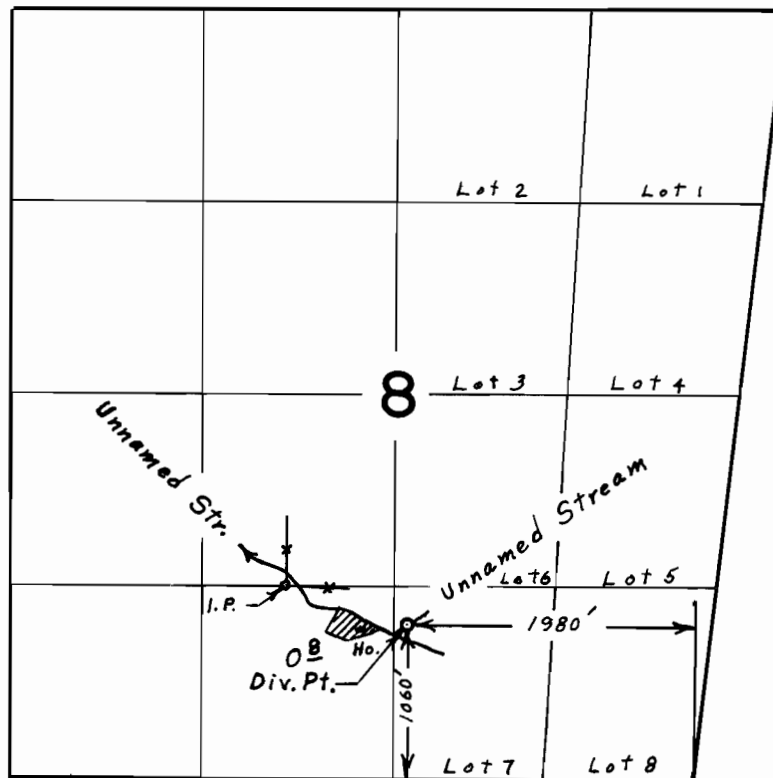

FINAL PROOF SURVEY
UNDER

Application No. 50966 Permit No. 38473
IN NAME OF

RAY & BONNIE PRATT

Surveyed May 28, 1976, by L. E. Gould