


T.22S. R.30E. W.M.

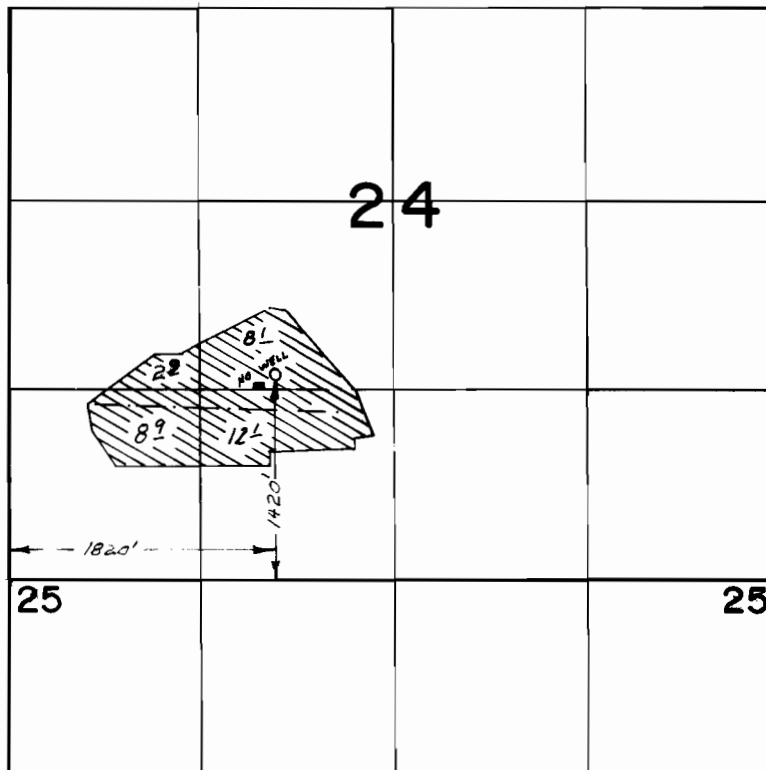

**FINAL PROOF SURVEY**  
UNDER

Application No. G-7577 Permit No. G-7049  
IN NAME OF

WILLIAM H. BEAL

Surveyed OCT. 18, 1977, by L.H. NUNN