


T.30S.R.33E.W.M.

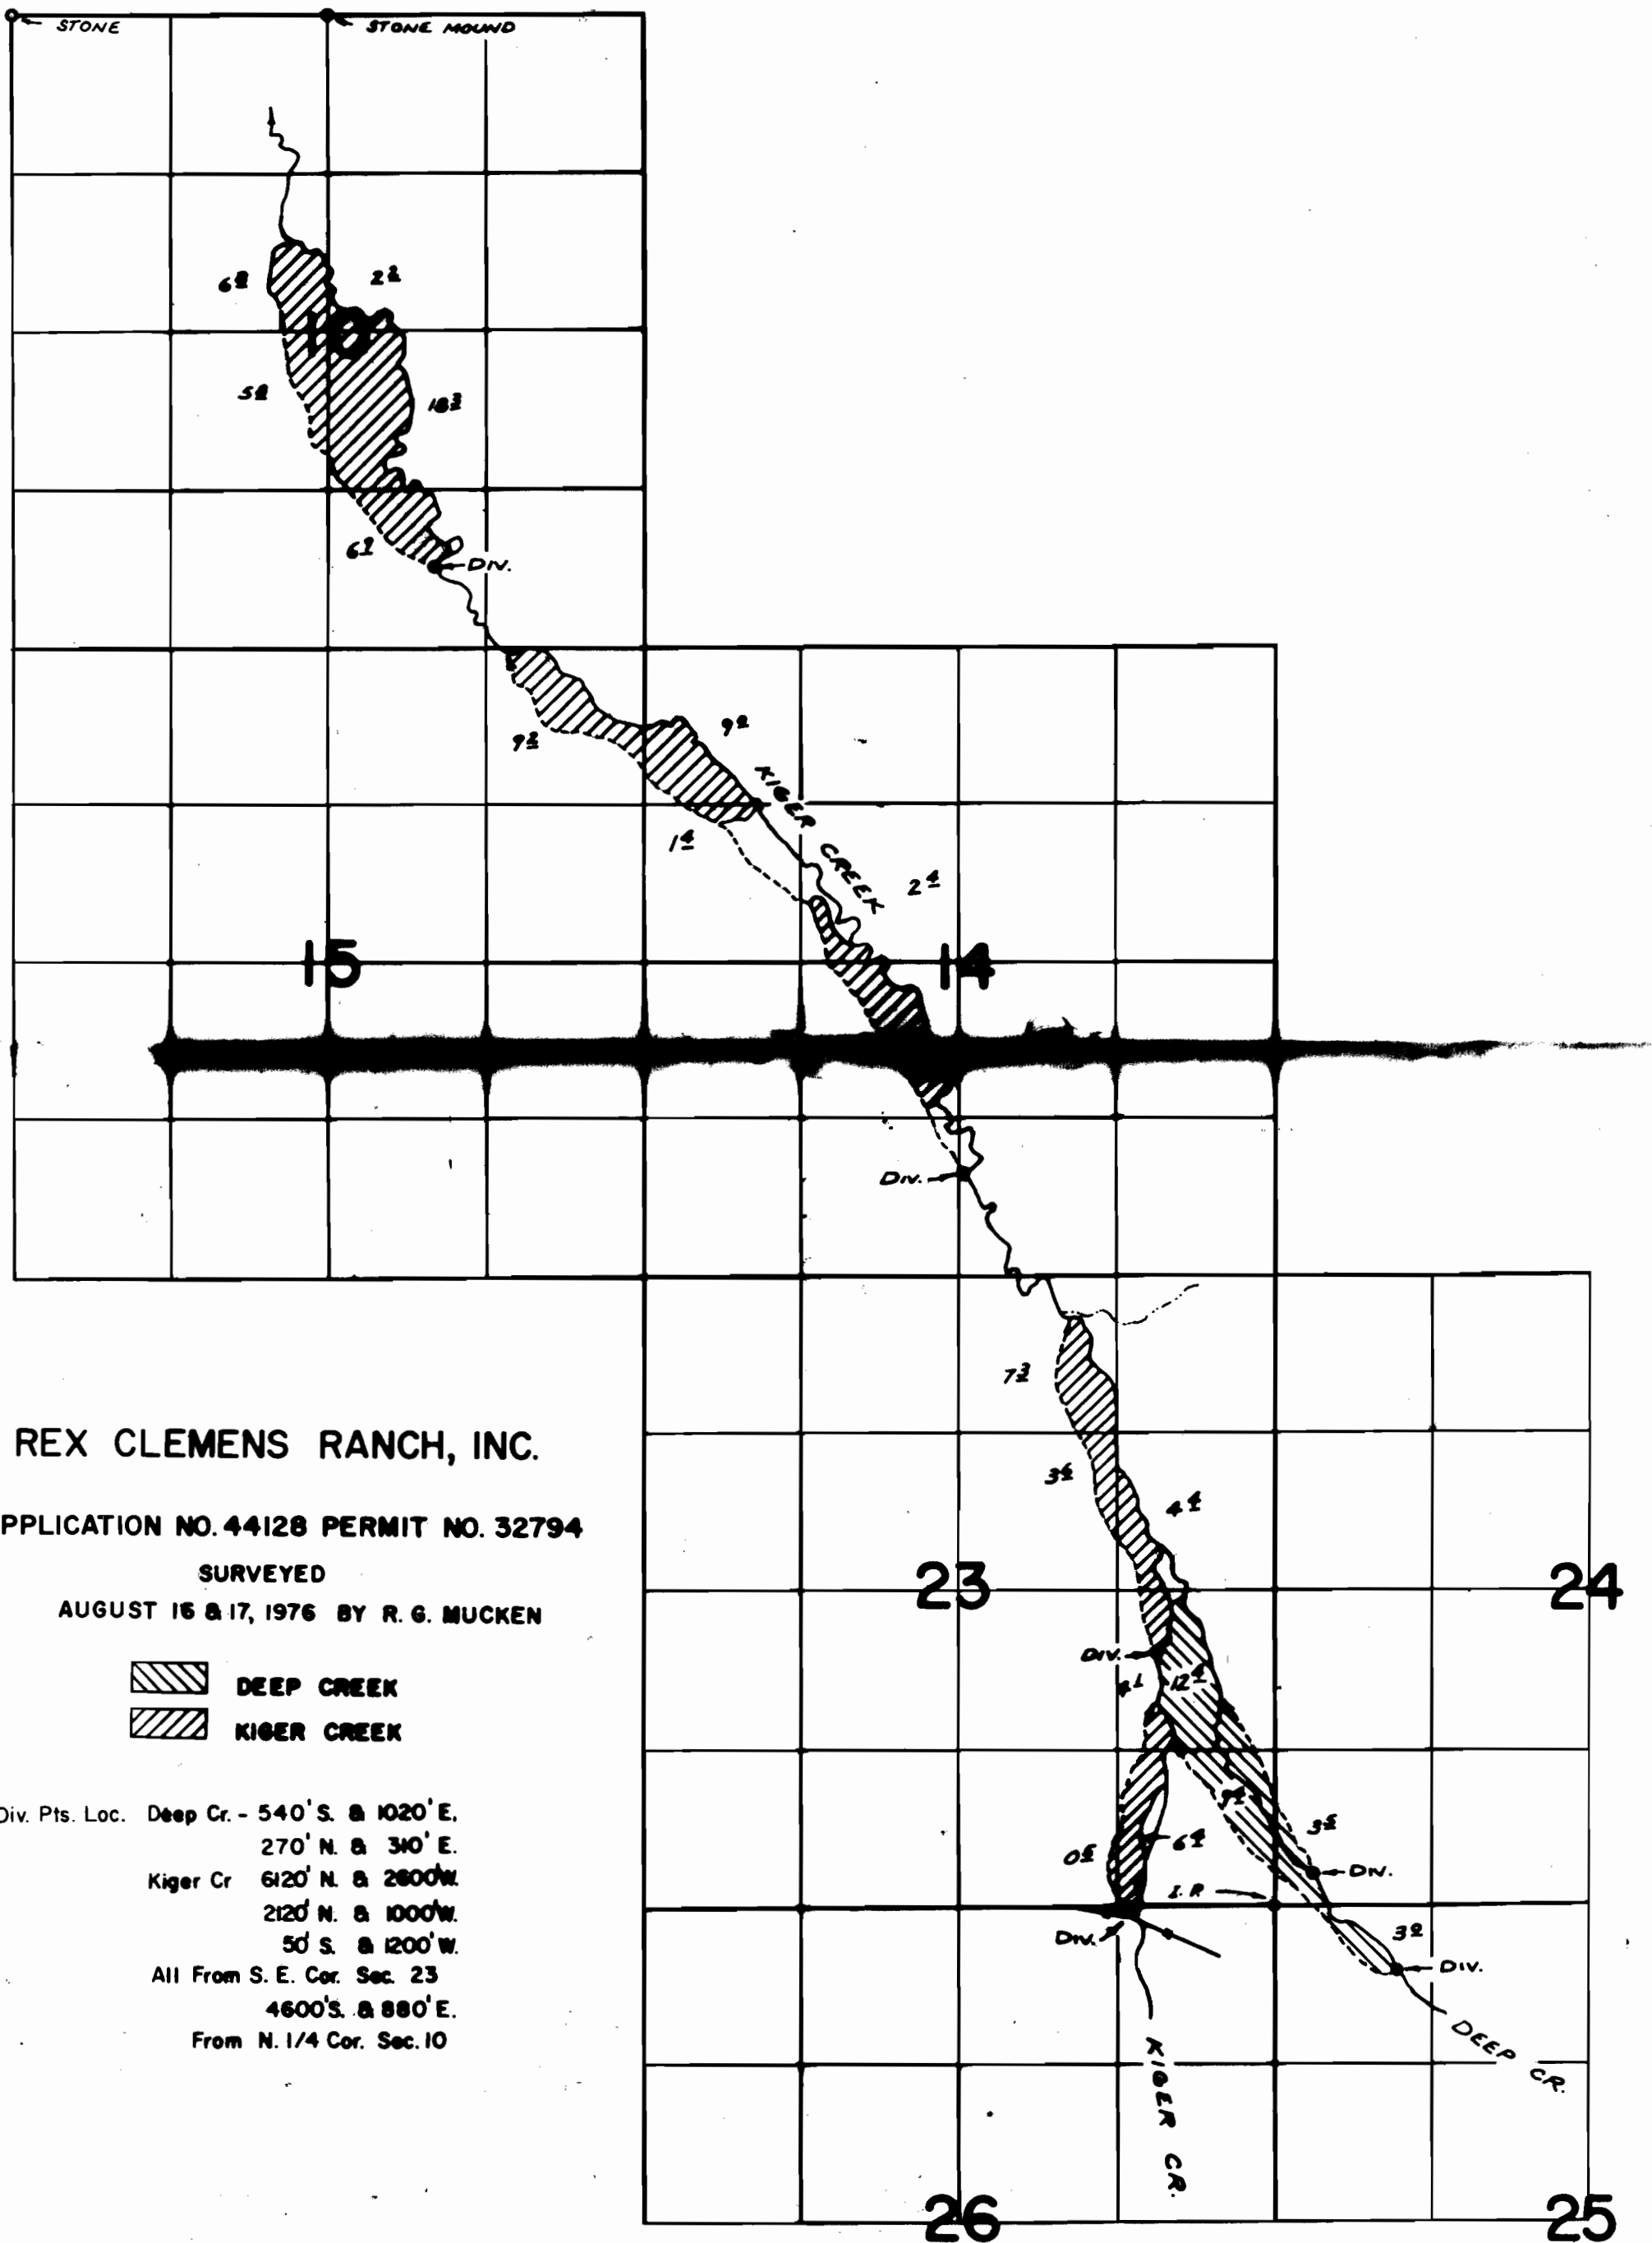

REX CLEMENS RANCH, INC.

APPLICATION NO. 44128 PERMIT NO. 32794

SURVEYED

AUGUST 16 & 17, 1976 BY R. G. MUCKEN

DEEP CREEK
 KIGER CREEK

Div. Pts. Loc. Deep Cr. - 540' S. & 1020' E.
 270' N. & 310' E.
 Kiger Cr 6120' N. & 2800' W.
 2120' N. & 1000' W.
 50' S. & 1200' W.
 All From S. E. Cor. Sec. 23
 4600' S. & 880' E.
 From N. 1/4 Cor. Sec. 10