


# T. 36S.R.4W.W.M.

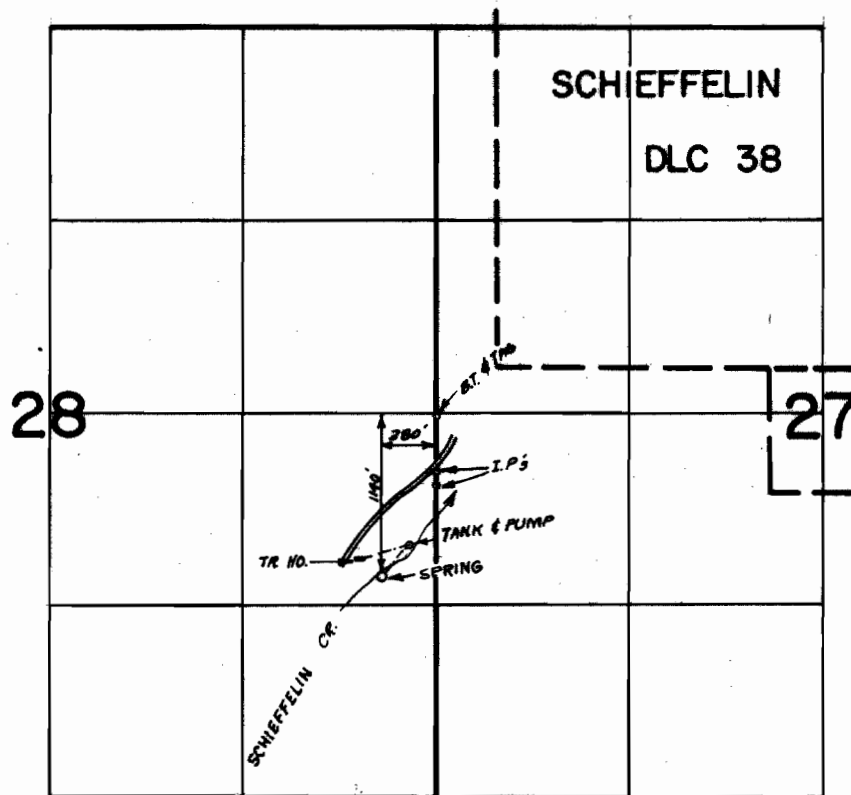

## FINAL PROOF SURVEY UNDER

Application No. 47816 Permit No. 35328  
IN NAME OF

PAUL F. MARTIN

Surveyed OCT 13 1973, by R.G. MUCKEN