


T. 38S. R. 2W.W.M.

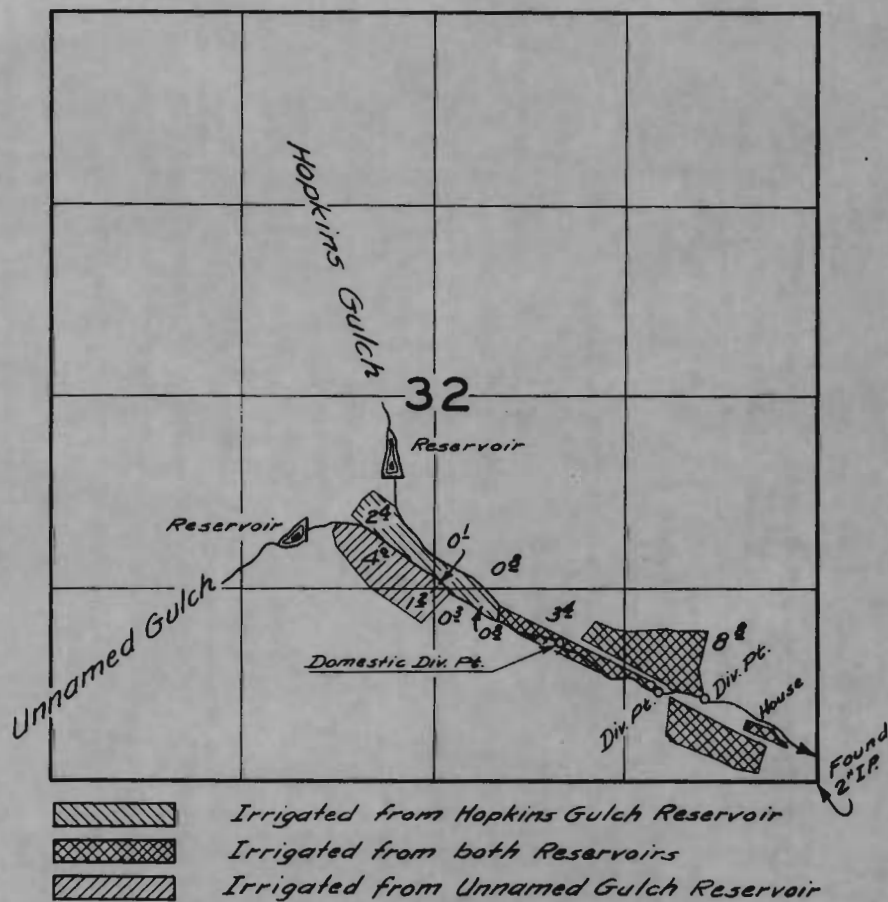

FINAL PROOF SURVEY
UNDER

Application No. ^{R-24784} 24785 Permit No. ^{R-1058} 19669
IN NAME OF

Albert Nelson

Surveyed April 14, 1960, by *C.O. Bartels*