


T.26S., R.3W., W.M.

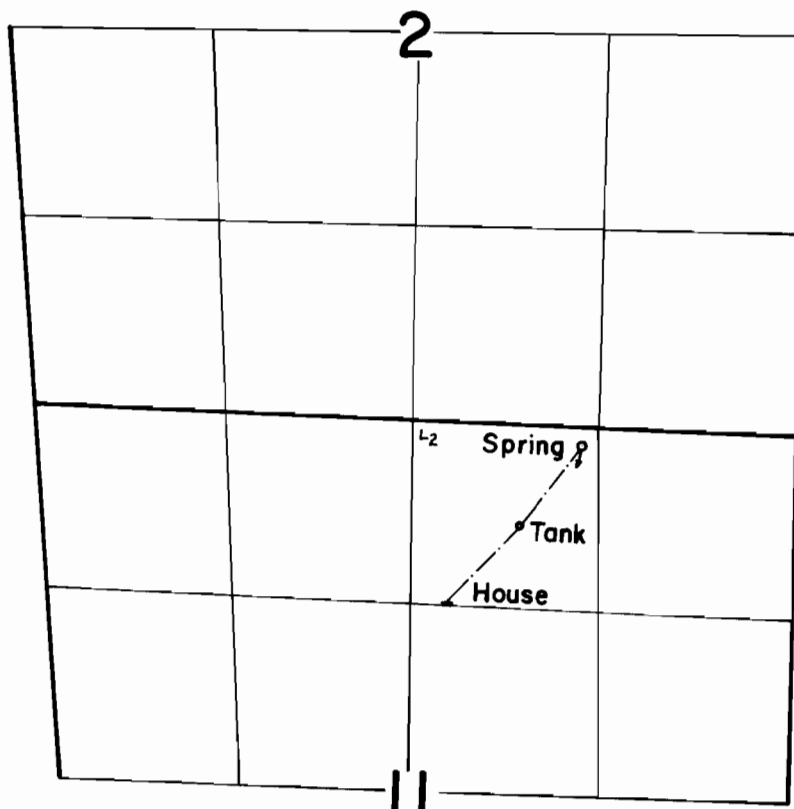

DIV PT. LOC: 130' S & 1160' E FROM N $\frac{1}{4}$ COR. SEC. 11

FINAL PROOF SURVEY
UNDER

Application No. 52723 Permit No. 39704
IN NAME OF

DAVID AND MAYME COTA

Surveyed Sept. 1, 1976, by D. Norby