


T. 34 S. R. 4 W. W.M.

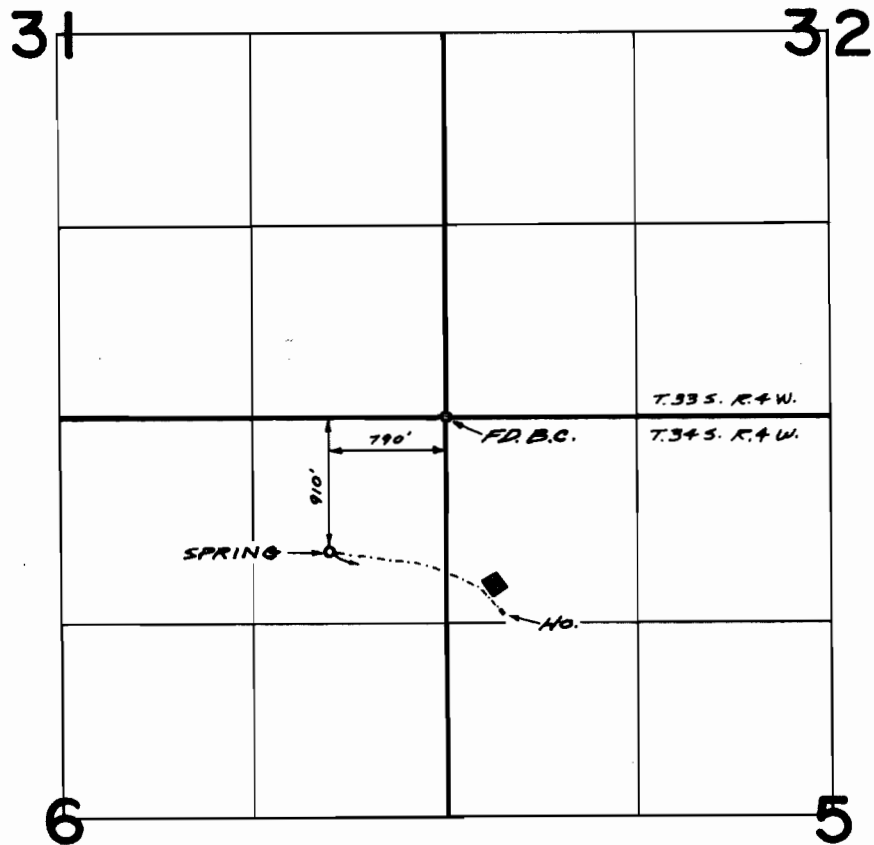

FINAL PROOF SURVEY
UNDER

Application No. 18102 Permit No. 36316
IN NAME OF

Kenneth B. Russell

Surveyed JULY 23 1974, by D. NORBY